


Give All Information Completely
Make Required Affidavit
Mail or Deliver Report to:
Conservation Division
State Corporation Commission
211 No. Broadway
Wichita, Kansas

15-065-00491-00-00
WELL PLUGGING RECORD

NORTH

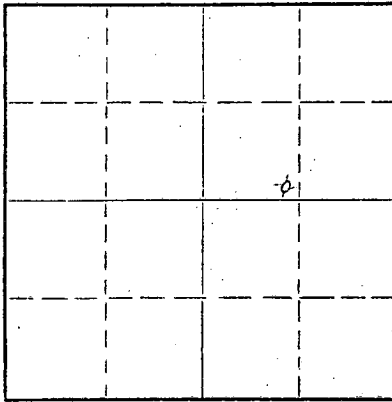

Locate well correctly on above
Section Plat

Graham County. Sec. 27 Twp 9S Rge. 23W (E) (W)
Location as "NE/CNW/SW" or footage from lines SE 1/4 SW 1/4 NE 1/4
Lease Owner LEBEN DRILLING, INC.
Lease Name SPARKS #1 Well No. 1
Office Address 905 CENTRAL BLDG., WICHITA, KANSAS
Character of Well (completed as Oil, Gas or Dry Hole) DRY HOLE
Date well completed 8-3-58 19
Application for plugging filed 8-3-58 19
Application for plugging approved 8-3-58 19
Plugging commenced 8-3-58 19
Plugging completed 8-3-58 19
Reason for abandonment of well or producing formation Dry Hole

If a producing well is abandoned, date of last production _____ 19____
Was permission obtained from the Conservation Division or its agents before plugging was commenced? Yes

Name of Conservation Agent who supervised plugging of this well A.D. Fabricius
Producing formation _____ Depth to top _____ Bottom _____ Total Depth of Well 3980 Feet
Show depth and thickness of all water, oil and gas formations.

OIL, GAS OR WATER RECORDS

CASING RECORD

FORMATION	CONTENT	FROM	TO	SIZE	PUT IN	PULLED OUT
				8 5/8"	209'	

Describe in detail the manner in which the well was plugged, indicating where the mud fluid was placed and the method or methods used in introducing it into the hole. If cement or other plugs were used, state the character of same and depth placed, from _____ feet to _____ feet for each plug set:

1st plug set at 550' with 1/2 sack hulls & 25 sacks cement.
2nd plug set at 250' with 1/2 sack hulls & 15 sacks cement.
top plug set at 40' with 1/2 sack hulls & 10 sacks cement.

(If additional description is necessary, use BACK of this sheet)

Name of Plugging Contractor Leben Drilling, Inc.
Address 905 Central Bldg., Wichita, Kansas

STATE OF Kansas, COUNTY OF Sedgwick, ss.
Frank Hamlin, (employee of owner) or (owner or operator) of the above-described well, being first duly sworn on oath, says: That I have knowledge of the facts, statements, and matters herein contained and the log of the above-described well as filed and that the same are true and correct. So help me God.

(Signature) Frank Hamlin
905 Central Bldg., Wichita, Kansas
(Address)

SUBSCRIBED AND SWORN to before me this 6th day of August, 1958

My commission expires June 17, 1961.

Ruth N. Benjamin
Ruth N. Benjamin, Notary Public.
STATE CORPORATION COMMISSION

PLUGGING
FILE SEC. 27 T. 9 R. 23W
BOOK PAGE 122 LINE 44

AUG 14 1958
CONSERVATION DIVISION
Wichita, Kansas

8-14-58

DRILLER'S LOG

COMPANY:
CONTRACTOR:
FARM:
LOCATION:
COMMENCED:
COMPLETED:

LEBEN DRILLING, INC.
 LEBEN DRILLING, INC.
 SPARKS #1
 SE 1/4 SW 1/4 NE 1/4 SEC. 27-9S-23W
 GRAHAM COUNTY, KANSAS
 7-25-58
 8-3-58

0	145	Surface Clay & Sand		
145	190	Shale & Sand		
190	209	Shale	TOPS:	
209	970	Shale & Shells	ANHYDRITE	2017
970	1110	Sand & Shale	HEEBNER	3700
1110	1300	Shale & Shells	TORONTO	3722
1300	1520	Shale	LANSING - K.C.	3735
1520	1735	Shale & Sand	BASE - K.C.	3961
1735	1990	Shale & Redbed		
1990	2020	Redbed	ELEVATION	2435 K.B.
2020	2053	Anhydrite		
2053	2190	Shale & Shell		
2190	2400	Shale & Lime		
2400	2545	Shale & Shells		
2545	3130	Shale & Lime		
3130	3778	Shale & Lime		
3778	3961	Lime		
3961	3980	Shale		
	3980	<u>Rotary Total Depth D & A</u>		

Set 209' of 8 5/8" surface casing with 160 sacks cement & 3 sacks CaCl.

I, Frank Hamlin, do hereby certify that the above and foregoing is a true and correct copy of the log of the Sparks #1, located SE 1/4 SW 1/4 NE 1/4 of Section 27, Township 9 South, Range 23W, Graham County, Kansas, as reflected by the files of Leben Drilling, Inc.

LEBEN DRILLING, INC.

By: Frank Hamlin
 Frank Hamlin

STATE OF KANSAS }
 COUNTY OF SEDGWICK } SS

Subscribed and sworn to before me, a Notary Public, in and for Sedgwick County, Kansas, this 6th day of August 1958.

Ruth M. Benjamin
 Ruth M. Benjamin, Notary Public

My Commission Expires:
 June 17, 1961.

PLUGGING
 FILE SEC. 27 T. 9 R. 23W
 BOOK PAGE 122 LINE 44

8-14-58