

STATE CORPORATION COMMISSION OF KANSAS
OIL & GAS CONSERVATION DIVISION

WELL COMPLETION OR RECOMPLETION FORM
ACO-1 WELL HISTORY

DESCRIPTION OF WELL AND LEASE

Operator: License # 6772
Name V. FRANCIS WEIGEL
Address Box 244
GOSHAM, KANS. 67640
City/State/Zip

Purchaser N/A

Operator Contact Person V. Francis Weigel
Phone 913-637-5383

Contractor: License # 5655
Name Shields Drilling Co. Inc

Wellsite Geologist F. C. Whisler
Phone 913-483-3020

Designate Type of Completion
 New Well Re-Entry Workover
 Oil SWD Temp Abd
 Gas Inj Delayed Comp.
 Dry Other (Core, Water Supply etc.)

If OWWO: old well info as follows:
Operator
Well Name
Comp. Date Old Total Depth

WELL HISTORY

Drilling Method:
 Mud Rotary Air Rotary Cable
9-21-81 9-28-81 N/A
Spud Date Date Reached TD Completion Date
350.5 N/A
Total Depth PBDT


Amount of Surface Pipe Set and Cemented at 208 feet
Multiple Stage Cementing Collar Used? Yes No
If yes, show depth set... feet
If alternate 2 completion, cement circulated from 208 feet depth to surface w/ 1.55 SX cmt

API NO. 15-051-22,588-00-00
County ELLIS
SW SE NE Sec. 5 Twp. 11 Rge. 16 East West

2970 Ft North from Southeast Corner of Section
990 Ft West from Southeast Corner of Section
(Note: Locate well in section plat below)

Lease Name CRAIG Well # 2
Field Name LEYEB
Producing Formation N/A

Elevation: Ground 1960 KB 1965
Section Plat

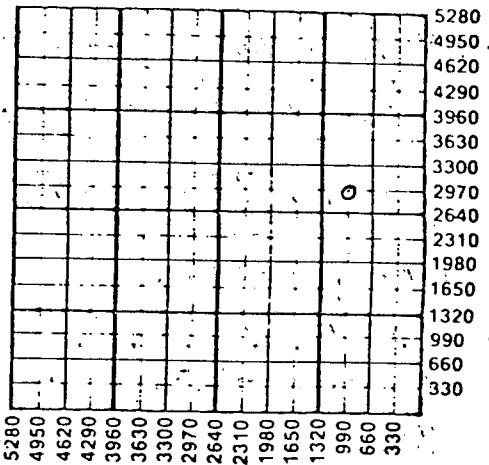

WATER SUPPLY INFORMATION

Disposition of Produced Water: Disposal Repressuring
Docket #

Questions on this portion of the ACO-1 call:
Water Resources Board (913) 296-3717

Source of Water:
Division of Water Resources Permit #
 Groundwater... Ft North from Southeast Corner (Well) ... Ft West from Southeast Corner of Sec Twp Rge East West
 Surface Water 1980 Ft North from Southeast Corner (Stream, pond etc) 1320 Ft West from Southeast Corner Sec 5 Twp 11 Rge 16 East West
 Other (explain) (purchased from city, R.W.D. #)

INSTRUCTIONS: This form shall be completed in duplicate and filed with the Kansas Corporation Commission, 200 Colorado Derby Building, Wichita, Kansas 67202, within 90 days after completion or recompletion of any well. Rule 82-3-130 and 82-3-107 apply.
Information on side two of this form will be held confidential for a period of 12 months if requested in writing and submitted with the form. See rule 82-3-107 for confidentiality in excess of 12 months.
One copy of all wireline logs and drillers time log shall be attached with this form. Submit CP-4 form with all plugged wells. Submit CP-111 form with all temporarily abandoned wells.

All requirements of the statutes, rules and regulations promulgated to regulate the oil and gas industry have been fully complied with and the statements herein are complete and correct to the best of my knowledge.

Signature Joan Weigel
Title Owner-Operator Date 1-26-85

Subscribed and sworn to before me this 26 day of January 1985.
Notary Public Joan Weigel
Date Commission Expires 1-19-89

K.C.C. OFFICE USE ONLY
F Letter of Confidentiality Attached
C Wireline Log Received
C Drillers Timelog Received
Distribution
 XCC SWD/Rep NGPA
 KGS Plug Other (Specify)

Joan Weigel
NOTARY PUBLIC
State of Kansas
MY APPT. EXPIRES 1-19-89

Sec. 5 Twp. 11 Rge. 16 W

Operator Name V. Francis Weigel Lease Name CRAIG Well # 2

Sec. 5 Twp. 11 Rge. 16 East West County ELLIS

WELL LOG

INSTRUCTIONS: Show Important tops and base of formations penetrated. Detail all cores. Report all drill stem tests giving interval tested, time tool open and closed, flowing and shut-in pressures, whether shut-in pressure reached static level, hydrostatic pressures, bottom hole temperature, fluid recovery, and flow rate. If gas to surface during test. Attach extra sheet if more space is needed. Attach copy of log.

Drill Stem Tests Taken Yes No
 Samples Sent to Geological Survey Yes No
 Cores Taken Yes No

Formation Description
 Log Sample

DST #1: 3474-3505
 30-45-45-45 Strong Blow
 Recovery: 800' mdy ctr.
 LFP: 109-193
 IBHP: 1052
 FFP: 277-370
 FBHP: 1008

Name	Top	Bottom
Anhydrite	1145	1178
Topeka	2896	
Heebner	3136	
Toronto	3159	
Lansing-KC	3178	
Base K.C.		3427
Congl. Sand	3496	
T.D.	3505	

RECEIVED
 STATE CORPORATION COMMISSION
 1-31-1985
 JAN 31 1985

CONSERVATION DIVISION
 Wichita, Kansas

CASING RECORD <input checked="" type="checkbox"/> New <input type="checkbox"/> Used							
Report all strings set-conductor, surface, intermediate, production, etc.							
Purpose of String	Size Hole Drilled	Size Casing Set (in O.D.)	Weight Lbs/Ft.	Setting Depth	Type of Cement	#Sacks Used	Type and Percent Additives
Surface	12 1/4"	8 5/8"	24#	208'	Quickset	155	
PERFORATION RECORD <u>N/A</u>				Acid, Fracture, Shot, Cement Squeeze Record			
Shots Per Foot	Specify Footage of Each Interval Perforated			(Amount and Kind of Material Used)		Depth	
TUBING RECORD <u>N/A</u>				Size	Set At	Packer at	Liner Run <input type="checkbox"/> Yes <input type="checkbox"/> No
Date of First Production	Producing Method <input type="checkbox"/> Flowing <input type="checkbox"/> Pumping <input type="checkbox"/> Gas Lift <input type="checkbox"/> Other (explain).....						
Estimated Production Per 24 Hours	Oil Bbls	Gas MCF	Water Bbls	Gas-Oil Ratio	Gravity		

METHOD OF COMPLETION N/A Production Interval

Disposition of gas: Vented Open Hole Perforation
 Sold Other (Specify)
 Used on Lease Dually Completed
 Comingled