


Give All Information Completely
Make Required Affidavit
Mail or Deliver Report to:
Conservation Division
State Corporation Commission
211 No. Broadway
Wichita, Kansas

WELL PLUGGING RECORD

NORTH

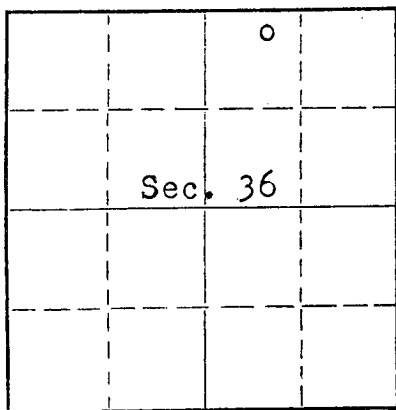

Locate well correctly on above Section Plat

Graham County, Sec. 36 Twp. 9 Rge. 23 (E) (W)
Location as "NE/CNW/SE/SW" or footage from lines. NE NW NE
Lease Owner Petroleum, Inc.
Lease Name Lacerte "C" Well No. 7
Office Address Route 2, Great Bend, Kansas
Character of Well (completed as Oil, Gas or Dry Hole) Dry Hole
Date well completed June 28, 19 58
Application for plugging filed July 1, 19 58
Application for plugging approved June 28, 19 58
Plugging commenced June 28, 19 58
Plugging completed June 28, 19 58
Reason for abandonment of well or producing formation No Producing Zones

If a producing well is abandoned, date of last production None 19
Was permission obtained from the Conservation Division or its agents before plugging was commenced? Yes

Name of Conservation Agent who supervised plugging of this well A.D. Fabricius, Box 731, Hill City, Kansas

Producing formation ----- Depth to top ----- Bottom ----- Total Depth of Well 4063' Feet
Show depth and thickness of all water, oil and gas formations.

OIL, GAS OR WATER RECORDS

CASING RECORD

FORMATION	CONTENT	FROM	TO	SIZE	PUT IN	PULLED OUT
				8-5/8"	281	None

Describe in detail the manner in which the well was plugged, indicating where the mud fluid was placed and the method or methods used in introducing it into the hole. If cement or other plugs were used, state the character of same and depth placed, from _____ feet to _____ feet for each plug set.

Mud up with heavy mud to 600' pushed 1/3 sack hulls to 600' followed by a wooden plug. Placed 25 sacks cement through drill pipe on to plug.
Mud up to 275' pushed 1/3 sack hulls to 275' followed by a wooden plug.
Placed 15 sacks cement through drill pipe on to plug. Mud up to 40' pushed 1/3 sack hulls to 40' followed by a wooden plug and 10 sacks cement to base of well cellar.

(If additional description is necessary, use BACK of this sheet)

Name of Plugging Contractor Garvey Drilling Company
Address Route 2, Great Bend, Kansas

STATE OF Kansas, COUNTY OF Barton, ss.
R.D. Brew (employee of owner) or (owner or operator) of the above-described well, being first duly sworn on oath, says: That I have knowledge of the facts, statements, and matters herein contained and the log of the above-described well as filed and that the same are true and correct. So help me God.

(Signature) R.D. Brew
Route 2, Great Bend, Kansas
(Address)

SUBSCRIBED AND SWORN to before me this 3rd. day of July, 19 58

Jed T. Brown
Notary Public.

My commission expires July 11, 1960

PLUGGING
FILE SEC. 36 T. 9 R. 23W
BOOK PAGE 114 LINE 2

RECEIVED
STATE CORPORATION COMMISSION
7-7-58
JUL 7 1958
CONSERVATION DIVISION
Wichita, Kansas

WELL LOG

COMPANY PETROLEUM, INCORPORATED

SEC. 36 T. 9S R. 23W

FARM LACERTE "C" NO. 7

LOC. NE, NW, NE


TOTAL DEPTH 4063'

COUNTY GRAHAM CO., KANSAS

COMM. June 19, 1958

COMP. June 28, 1958

CONTRACTOR GARVEY DRILLING COMPANY

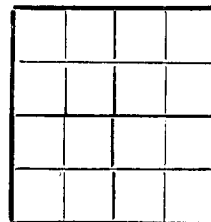

CASING 8 5/8" @ 281' W/200 sax.

ELEVATION 2371' DF

PRODUCTION D & A

FIGURES INDICATE BOTTOM OF FORMATIONS

15	Surface soil
190	Clay & sand
283	Shale & shells
375	Shale, blue
600	Shale & shells
960	Shale, shells w/sand streaks
1290	Shale, shells & sand
1350	Sand & shale
1490	Shale & shells
1600	Sand
1725	Sand & shale
1955	Red bed & shale
1990	Anhydrite
2080	Shale
2310	Shale, shells w/lime streaks
2460	Shale w/lime streaks
2660	Shale
2777	Shale & lime
2990	Shale w/lime streaks
3115	Shale
3205	Shale w/lime streaks
3445	Shale
3700	Lime & shale
3830	Lime
3880	Lime & shale
3890	Lime
3982	Lime & shale w/sand
4063	Lime & chert
4063	T. D.

RECEIVED
STATE CORPORATION COMMISSION

JUL 7 1958

CONSERVATION DIVISION
Wichita, Kansas

PLUGGING
FILE SEC. 36 T. 9 R. 23W
BOOK PAGE 114 L.F. 2

State of KANSAS }
County of BARTON } ss:

I, VERNE A. MORRIS of GARVEY DRILLING COMPANY

upon oath state that the above and foregoing is a true and correct copy of the log of the #7 LACERTE "C" well

Verne A. Morris

Subscribed and sworn to before me this 2nd day of July 19 58

My Commission Expires: July 11, 1960

[Signature]
NOTARY PUBLIC