


WELL PLUGGING RECORD

Give All Information Completely
Make Required Affidavit
Mail or Deliver Report to:
Conservation Division
State Corporation Commission
211 No. Broadway
Wichita, Kansas

NORTH

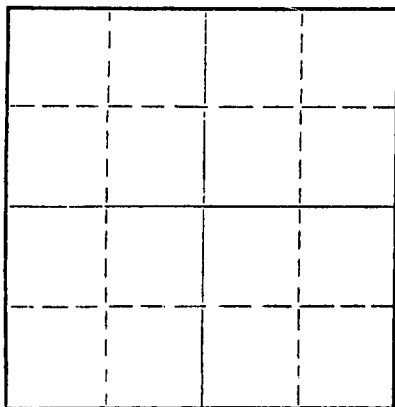

Locate well correctly on above
Section Plat

Graham County. Sec. 36 Twp. 9S Rge. 23W (E) (W)
Location as "NE/CNW/SW" or footage from lines NW NW NW
Lease Owner Don E. Pratt, Oil Operator
Lease Name XXX Rice Well No. 1
Office Address Box 656, Hays, Kansas 67601
Character of Well (completed as Oil, Gas or Dry Hole) Dry Hole
Date well completed 7-26-64 19__
Application for plugging filed 7-26-64 19__
Application for plugging approved 7-26-64 19__
Plugging commenced 7-26-64 19__
Plugging completed 7-26-64 19__
Reason for abandonment of well or producing formation Dry Hole

If a producing well is abandoned, date of last production _____ 19__
Was permission obtained from the Conservation Division or its agents before plugging was commenced? yes

Name of Conservation Agent who supervised plugging of this well Bill Nichols, Moreland, Kansas
Producing formation _____ Depth to top _____ Bottom _____ Total Depth of Well 3910 Feet
Show depth and thickness of all water, oil and gas formations.

OIL, GAS OR WATER RECORDS

CASING RECORD

FORMATION	CONTENT	FROM	TO	SIZE	PUT IN	PULLED OUT
				8 5/8"	212'	none

Describe in detail the manner in which the well was plugged, indicating where the mud fluid was placed and the method or methods used in introducing it into the hole. If cement or other plugs were used, state the character of same and depth placed, from _____ feet to _____ feet for each plug set.

Plug 20 sks. cement @ 600'
Plug 1/2 sk. hulls 20 sks. cement @ 200'
Plug 1/2 sk. hulls 10 sks. cement @ 40'

RECEIVED
STATE CORPORATION COMMISSION
7-29-64
JUL 29 1964

CONSERVATION DIVISION
Wichita, Kansas

(If additional description is necessary, use BACK of this sheet)

Name of Plugging Contractor Leben Drilling, Inc.
Address Box 486, Great Bend, Kansas

STATE OF KANSAS, COUNTY OF BARTON, ss.

Leslie Kite (employee of owner) or (owner or operator) of the above-described well, being first duly sworn on oath, says: That I have knowledge of the facts, statements, and matters herein contained and the log of the above-described well as filed and that the same are true and correct. So help me God.

(Signature) Leslie Kite

P. O. Box 486, Great Bend, Kansas
(Address)

SUBSCRIBED AND SWORN TO before me this 28th day of July, 19 64

My commission expires April 1, 1967

Ulanda Nichols
Ulanda Nichols Notary Public.

DRILLER'S LOG

COMPANY: Don E. Pratt, Oil Operator
 CONTRACTOR: LEBEN DRILLING, INC.
 FARM: Rice #1
 LOCATION: NW NW NW Sec. 36-9S-23W
 GRAHAM COUNTY, KANSAS
 COMMENCED: 7-18-64
 COMPLETED: 7-26-64

0	110	Shale & Sand
110	213	Shale & Shells
213	300	Shale
300	1485	Shale & Shells
1485	1700	Sand
1700	1958	Red Rock & Shale
1958	1995	Anhydrite
1995	2520	Shale & Shells
2520	2775	Shale with Lime
2775	3135	Lime & Shale
3135	3300	Lime
3300	3575	Lime & Shale
3575	3910	Lime
	<u>3910</u>	<u>Rotary Total Depth - D. & A.</u>

RECEIVED
 STATE CORPORATION COMMISSION
 JUL 29 1964
 CONSERVATION DIVISION
 Wichita, Kansas

Set 8 5/8" used surface casing @ 212' with 175 sacks 50-50 Posmix with HA5.

I, Leslie Kite, do hereby certify that the above and foregoing is a true and correct copy of the log of the Rice #1 well, located NW NW NW of Section 36, Township 9 South, Range 23 West, Graham County, Kansas, as reflected by the files of Leben Drilling, Inc.

Leslie Kite

 Leslie Kite

STATE OF KANSAS)
) SS
 COUNTY OF BARTON)

Subscribed and sworn to before me, a Notary Public, in and for Barton County, Kansas, this 28th day of July, 1964.

Ulanda Nichols

 Ulanda Nichols, Notary Public

My Commission Expires:
 April 1, 1967

