


STATE OF KANSAS
STATE CORPORATION COMMISSION
200 Colorado Derby Bldg.
Wichita, Kansas 67202

Form CP-4
Rev. 12-15-80

WELL PLUGGING RECORD

Give All Information Completely
Make Required Affidavit

COUNTY Graham SEC. 36 TWP. 9S RGE. 23 ~~XY~~W
Location as in quarters or footage from lines:
SE SW NW

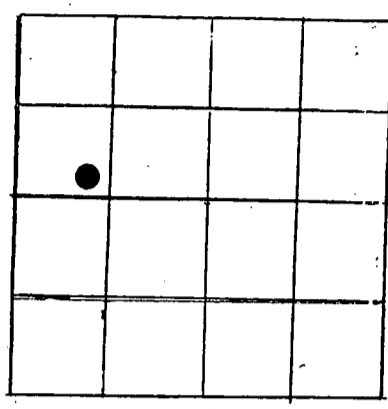

Locate Well
correctly on above
Section Platt.

Lease Owner Petroleum, Inc.
Lease Name Vesper L-KC Unit (Clara Rice A) Well No. #1-2 (#2)
Office Address P. O. Box 1447, Great Bend, Kansas 67530
Character of Well (Completed as Oil, Gas or Dry Hole): Oil
Date Well Completed November, 1957
Application for plugging filed October 18, 1982
Plugging commenced November 30, 1982
Plugging completed November 30, 1982
Reason for abandonment of well or producing formation
Uneconomical

Was permission obtained from the Conservation Division or it's
Agent's before plugging was commenced? Yes

Name of Conservation Agent who supervised plugging of this well Carl Goodrow
Producing formation L-KC Depth to top 3700 bottom 3929 T.D. 3935
Show depth and thickness of all water, oil and gas formations.

OIL, GAS OR WATER RECORDS Casing Record

Formation	Content	From	To	Size	Put in	Pulled Out
				8-5/8	250	-0-
				5 1/2	3934	-0-

Describe in detail the manner in which the well was plugged, indicating where the mud
fluid was placed and the method or methods used in introducing it into the hold. If cement
or other plugs were used, state the character of same and depth placed, from _____ feet
to _____ feet for each plug set.

Pumped 20 sacks common cement, 2 sacks hulls down backside. Pumped 110 sacks common
cement, 130 sacks 50/50 pozmix, 15 sacks gel, 8 sacks CC down 5 1/2" casing. Shut in
@ 100%.


(If additional description is necessary, use BACK of this sheet)

Name of Plugging Contractor Allied Cementing Co., Inc.

STATE OF Kansas COUNTY OF Barton, ss.
Terry Naylor (employee of owner) or (owner or operator) of the
above-described well, being first duly sworn on oath, says: That I have knowledge of the
facts, statements, and matters herein contained and the log of the above-described well as
filed and that the same are true and correct. So help me God.

(Signature) Terry Naylor
Box 1447, Great Bend, KS 67530
(Address)

SUBSCRIBED AND SWORN TO before me this 14th day of December, 19 82

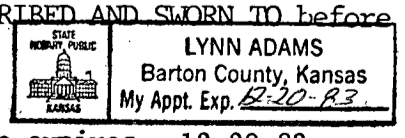

My Commission expires: 12-20-83

RECEIVED
Notary Public
STATE CORPORATION COMMISSION
12-15-82
DEC 15 1982

CONSERVATION DIVISION
Wichita, Kansas