

Give All Information Completely
Make Required Affidavit
Mail or Deliver Report to:
Conservation Division
State Corporation Commission
800 Biting Building
Wichita, Kansas

WELL PLUGGING RECORD

Graham County, Sec 35 Twp 9S Rge. (E) 23 (W)

Location as "NE/CNW $\frac{1}{4}$ SW $\frac{1}{4}$ " or footage from lines SW $\frac{1}{4}$ -SE $\frac{1}{4}$ -NW $\frac{1}{4}$

Lease Owner Champlin Refining Company

Lease Name Clara F. Rice Well No. 2

Office Address Dr. #552, Enid, Oklahoma.

Character of Well (completed as Oil, Gas or Dry Hole) Dry hole

Date well completed June 13, 19 51

Application for plugging filed June 13, 19 51

Application for plugging approved June 13, (Verbal) 19 51


Plugging commenced June 13, 19 51

Plugging completed June 13, 19 51

Reason for abandonment of well or producing formation.....

If a producing well is abandoned, date of last production..... 19.....

Was permission obtained from the Conservation Division or its agents before plugging was commenced? Yes

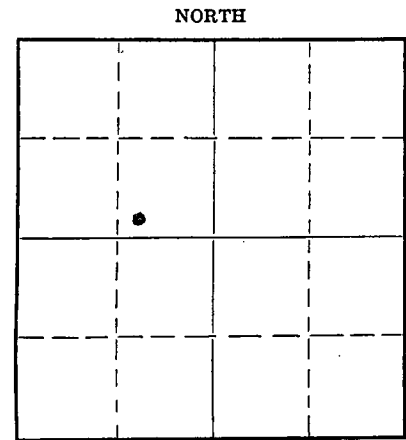

Locate well correctly on above Section Plat

Name of Conservation Agent who supervised plugging of this well Eldon Petty, Hays, Kansas.

Producing formation..... Depth to top..... Bottom..... Total Depth of Well 4265' Feet

Show depth and thickness of all water, oil and gas formations.

OIL, GAS OR WATER RECORDS

CASING RECORD

Formation	Content	From	To	Size	Put In	Pulled Out
				8 5/8"	190'	None

Describe in detail the manner in which the well was plugged, indicating where the mud fluid was placed and the method or methods used in introducing it into the hole. If cement or other plugs were used, state the character of same and depth placed, from.....feet to.....feet for each plug set.

Filled hole with heavy rotary mud from 4265' TD to 170' and set plug at 170' and pumped in 15 sacks of cement then filled hole with heavy rotary mud from top of cement to 40' from surface and filled hole to top using 10 sacks of cement. Used Globe Oil Well Cementing Company to plug this well.

6-26-51

(If additional description is necessary, use BACK of this sheet)

Correspondence regarding this well should be addressed to Champlin Refining Company
Address P. O. Dr. #552,
Enid, Oklahoma.

STATE OF Kansas COUNTY OF Barton, ss.
S. P. Hall (employee of owner) or ~~(owner)~~ of the above-described well,

being first duly sworn on oath, says: That I have knowledge of the facts, statements, and matters herein contained and the log of the above-described well as filed and that the same are true and correct. So help me God.

(Signature) S. P. Hall

Ellinwood, Kansas.
(Address)

SUBSCRIBED AND SWORN TO before me this 25th day of June 19 51

N. Kenneth Stevens
Notary Public.

My commission expires October 24, 1951

