

CARD MUST BE TYPED

State of Kansas
NOTICE OF INTENTION TO DRILL

corrected
CARD MUST BE SIGNED
3-14-85

(see rules on reverse side)

Starting Date: 3 26 85
month day year

NOTE: Corrected Location
API Number 15- 051-24,189-00-00

OPERATOR: License # 6772
NameV...Francis.Weigel.....
Address ...Box 244.....
City/State/Zip ..Gorham, Kansas...67640.....
Contact PersonV...Francis.Weigel.....
Phone913-637-5383.....

* SW . SW . SW Sec . 5 . Twp . 11 S, Rge . 16 . East
(location) West

.....330..... Ft North from Southeast Corner of Section
*4950..... Ft West from Southeast Corner of Section
(Note: Locate well on Section Plat on reverse side)

CONTRACTOR: License # 5655
Name Shields Drlg. Co., Inc.
City/State ..Russell, Kansas...67665.....

Nearest lease or unit boundary line 330 feet.
County Ellis
Lease Name Chesney "B" Well# 8

Domestic well within 330 feet : yes no
Municipal well within one mile : yes no

Well Drilled For: Well Class: Type Equipment:
 Oil Swd Infield Mud Rotary
 Gas Inj Pool Ext. Air Rotary
 OWWO Expl Wildcat Cable

Depth to Bottom of fresh water 125 feet
Lowest usable water formation Dakota, SS
Depth to Bottom of usable water 700 feet
Surface pipe by Alternate : 1 2
Surface pipe to be set 1100 feet
Conductor pipe if any required None feet
Ground surface elevation 1900 feet MSL
This Authorization Expires 9-12-85
Approved By 3-12-85
kwaz: SESESW 4250 FEL

If OWWO: old well info as follows:

Operator
Well Name
Comp Date Old Total Depth
Projected Total Depth 3500 feet
Projected Formation at TD Arbuckle
Expected Producing Formations L-KC

I certify that we will comply with K.S.A. 55-101, et seq., plus eventually plugging hole to K.C.C. specifications.

Date Signature of Operator or Agent V. Francis Weigel Title Owner


Must be filed with the K.C.C. five (5) days prior to commencing well
This card void if drilling not started within six (6) months of date received by K.C.C.

RECEIVED

STATE CORPORATION COMMISSION

MAR 14 1985

A Regular Section of Land -
1 Mile ^{1/2} x 5/8 Mile = 5280 Ft.

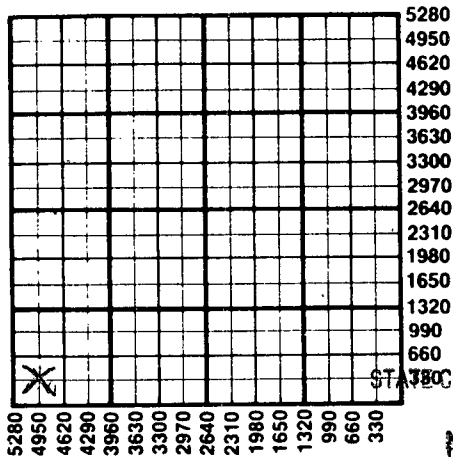

STATE CORPORATION COMMISSION

RECEIVED

3-14-1985
MAR 14 1985

CONSERVATION DIVISION
Wichita, Kansas

Important procedures to follow :

1. Notify District office before setting surface casing.
 2. Set surface casing by circulating cement to the top.
 3. File completion forms ACO-1 with K.C.C. within 90 days of well completion, following instructions on ACO-1, side 1, and including copies of wireline logs.
 4. Notify District office 48 hours prior to old well workover or re-entry.
 5. Prior to plugging, prepare a plugging plan, then obtain agreement from the appropriate district office for an approved plugging plan.
 6. Submit plugging report (CP-4) to K.C.C. after plugging is completed.
 7. Obtain an approved injection docket number before disposing of salt water.
 8. Notify K.C.C. within 10 days when injection commences or terminates.
- If an alternate 2 completion, cement in the production pipe from below any usable water to surface within 120 days of spud date.

State Corporation Commission of Kansas
Conservation Division
200 Colorado Derby Building
Wichita, Kansas 67202
(316) 263-3238