

CARD MUST BE TYPED

State of Kansas  
**NOTICE OF INTENTION TO DRILL**  
(see rules on reverse side)

CARD MUST BE SIGNED

Starting Date: ..... February 12, 1985  
month day year

API Number 15- 065-22,140 - 0000 <sup>2-14-85</sup>  
"CORRECTED INTENT"

OPERATOR: License # 9542  
Name Robert W. Myers  
Address 11945 Forestwood Drive  
City/State/Zip Dallas, TX 75234  
Contact Person Robert W. Myers  
Phone (214)-960-1332

X SW NW/4 ..... Sec .32. Twp 9... S, Rge .23\*  
(location)  East  West

3418 ..... Ft North from Southeast Corner of Section  
4078 ..... Ft West from Southeast Corner of Section  
(Note: Locate well on Section Plat on reverse side)

CONTRACTOR: License # 8241  
Name Emphasis Oil Operations  
City/State P.O., Box 506, Russell, KS 67665-0506

Nearest lease or unit boundary line ..... 778 ..... feet.  
County Graham  
Lease Name Myers-Justice Well# 2

Well Drilled For: Well Class: Type Equipment:  
 Oil  Swd  Infield  Mud Rotary  
 Gas  Inj  Pool Ext.  Air Rotary  
 OWWO  Expl  Wildcat  Cable

Domestic well within 330 feet :  yes  no  
Municipal well within one mile :  yes  no

If OWWO: old well info as follows:  
Operator .....  
Well Name ~~.....~~  
Comp Date ..... Old Total Depth .....  
Projected Total Depth 4050 ..... feet  
Projected Formation at TD Arbuckle  
Expected Producing Formations Arbuckle

Depth to Bottom of fresh water ..... 150 ..... feet  
Lowest usable water formation Dakota .....  
Depth to Bottom of usable water ..... 1040 ..... feet  
Surface pipe by Alternate : 1  2   
Surface pipe to be set ~~.....~~ 220 ..... feet  
Conductor pipe if any required None ..... feet  
Ground surface elevation ..... --- ..... feet MSL  
This Authorization Expires 8-4-85  
Approved By 2-4-85

I certify that we will comply with K.S.A. 55-101, et seq., plus eventually plugging hole to K.C.C. specifications. X was 32-9-22W

Date 2-13-85 Signature of Operator or Agent Joe R. Branum Title

Agent

Must be filed with the K.C.C. five (5) days prior to commencing well  
 This card void if drilling not started within six (6) months of date received by K.C.C.


RECEIVED  
 STATE CORPORATION COMMISSION

2-14-85  
 FEB 14 1985

Important procedures to follow:

A Regular Section of Land  
 1 Mile = 5,280 Ft.

CONSERVATION DIVISION  
 Wichita, Kansas

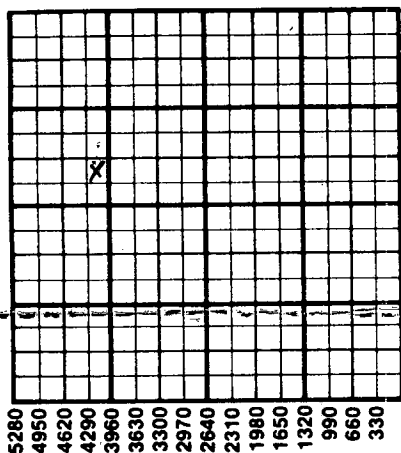

1. Notify District office before setting surface casing.
2. Set surface casing by circulating cement to the top.
3. File completion forms ACO-1 with K.C.C. within 90 days of well completion, following instructions on ACO-1, side 1, and including copies of wireline logs.
4. Notify District office 48 hours prior to old well workover or re-entry.
5. Prior to plugging, prepare a plugging plan, then obtain agreement from the appropriate district office for an approved plugging plan.
6. Submit plugging report (CP-4) to K.C.C. after plugging is completed.
7. Obtain an approved injection docket number before disposing of salt water.
8. Notify K.C.C. within 10 days when injection commences or terminates.
9. If an alternate 2 completion, cement in the production pipe from below any usable water to surface within 120 days of spud date.

State Corporation Commission of Kansas  
 Conservation Division  
 200 Colorado Derby Building  
 Wichita, Kansas 67202  
 (316) 263-3238