

CARD MUST BE TYPED

State of Kansas
NOTICE OF INTENTION TO DRILL
(see rules on reverse side)

CARD MUST BE SIGNED

Starting Date: Sept. 19, 1984
month day year

API Number 15- 065-22,073-0000

OPERATOR: License # 5886
Name Chief Drilling Co.
Address Century Plaza
City/State/Zip Wichita, Ks. 67202
Contact Person F. W. Shelton, Jr.
Phone 316-262-3791

SW NE SE ... Sec .20. Twp .9. S, Rge .23. East
 West
(location)

.....4290.... Ft North from Southeast Corner of Section
.....990.... Ft West from Southeast Corner of Section
(Note: Locate well on Section Plat on reverse side)

CONTRACTOR: License # 5883
Name Warrior Drilling Co. Rig #1
City/State Wichita, Ks.

Nearest lease or unit boundary line 330 feet.
County Graham

Lease Name Robinson Well# 1

Domestic well within 330 feet: yes no

Municipal well within one mile: yes no

Well Drilled For: Well Class: Type Equipment:
 Oil Swd Infield Mud Rotary
 Gas Inj Pool Ext. Air Rotary
 OWWO Expl Wildcat Cable

Depth to Bottom of fresh water 100 feet

Lowest usable water formation Lower Cretaceous *De la Torre*

Depth to Bottom of usable water 800 1125 feet

Surface pipe by Alternate: 1 2

Surface pipe to be set 250 feet

Conductor pipe if any required none feet

Ground surface elevation 2428' feet MSL

This Authorization Expires 3-19-85

Approved By F. W. Shelton

If OWWO: old well info as follows:

Operator
Well Name
Comp Date Old Total Depth
Projected Total Depth 4000 feet
Projected Formation at TD Lansing
Expected Producing Formations Lansing

I certify that we will comply with K.S.A. 55-101, et seq., plus eventually plugging hole to K.C.C. specifications.

Date 9-18-84 Signature of Operator or Agent

Title Vice President


MHC/KOHE 9/19/84

WICHITA, KANSAS

Must be filed with the K.C.C. five (5) days prior to commencing well
This card void if drilling not started within six (6) months of date received by K.C.C.


09-18-84

SEP 18 1984

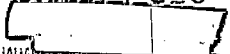

STATE CORPORATION COMMISSION

RECEIVED
A Regular Section of Land
1 Mile = 5,280 Ft.

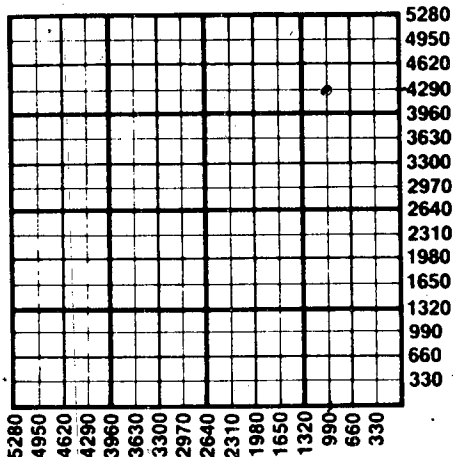

Important procedures to follow :

1. Notify District office before setting surface casing.
2. Set surface casing by circulating cement to the top.
3. File completion forms ACO-1 with K.C.C. within 90 days of well completion, following instructions on ACO-1, side 1, and including copies of wireline logs.
4. Notify District office 48 hours prior to old well workover or re-entry.
5. Prior to plugging, prepare a plugging plan, then obtain agreement from the appropriate district office for an approved plugging plan.
6. Submit plugging report (CP-4) to K.C.C. after plugging is completed.
7. Obtain an approved injection docket number before disposing of salt water.
8. Notify K.C.C. within 10 days when injection commences or terminates.
9. If an alternate 2 completion, cement in the production pipe from below any usable water to surface within 120 days of spud date.

**State Corporation Commission of Kansas
Conservation Division
200 Colorado Derby Building
Wichita, Kansas 67202
(316) 263-3238**