

Give All Information Completely
Make Required Affidavit
Mail or Deliver Report to:
Conservation Division
State Corporation Commission
212 No. Market
Wichita, Kansas

WELL PLUGGING RECORD

Ellis County. Sec 32 Twp 11S Rge. (E) 16 (W)

Location as "NE/CNW/SW" or footage from lines SE SE SE

Lease Owner Rains & Williamson Oil Co., Inc.

Lease Name CHRISLER (OWWO) Well No. 1

Office Address 1425 Wichita Plaza - Wichita, Kansas

Character of Well (completed as Oil, Gas or Dry Hole) dry hole

Date well completed 6-3 19 68

Application for plugging filed 6-3 19 68

Application for plugging approved 6-3 19 68


Plugging commenced 6-3 19 68

Plugging completed 3:00 A.M. 6-3 19 68

Reason for abandonment of well or producing formation No oil or gas found in commercial quantities.

If a producing well is abandoned, date of last production 19

Was permission obtained from the Conservation Division or its agents before plugging was commenced? Yes

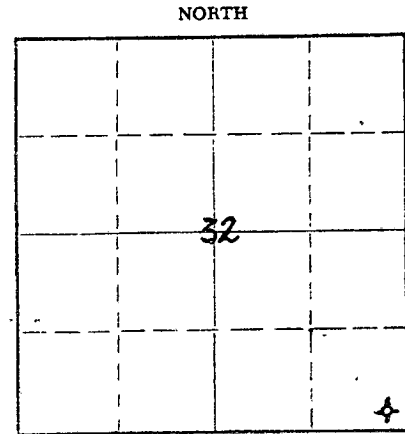

Locate well correctly on above Section Plat

Name of Conservation Agent who supervised plugging of this well Leo Massey, Hays, Kansas

Producing formation Depth to top Bottom Total Depth of Well 3450 Feet

Show depth and thickness of all water, oil and gas formations.

OIL, GAS OR WATER RECORDS

CASING RECORD

FORMATION	CONTENT	FROM	TO	SIZE	XXX	PULLED OUT
				8-5/8"	1014'	-0-
				(Existing casing in old hole)		

Describe in detail the manner in which the well was plugged, indicating where the mud fluid was placed and the method or methods used in introducing it into the hole. If cement or other plugs were used, state the character of same and depth placed, from feet to feet for each plug set.

Pushed plug and hulls to 550'. Cemented with 25 sacks. Mud back to 40'. Set solid bridge and capped with 10 sacks; 2 sacks in rat hole. Plugging completed 3:00 AM, 6-3-68.


RECEIVED
STATE CORPORATION COMMISSION
JUN 13 1968
CONSERVATION DIVISION
Wichita, Kansas

(If additional description is necessary, use BACK of this sheet)

Name of Plugging Contractor Rains & Williamson Oil Co., Inc.
Address 1425 Wichita Plaza - Wichita, Kansas

STATE OF KANSAS, COUNTY OF SEDGWICK, ss.
Wilson Rains (employee of owner) or (owner or operator) of the above-described well, being first duly sworn on oath, says: That I have knowledge of the facts, statements, and matters herein contained and the log of the above-described well as filed and that the same are true and correct. So help me God

(Signature) Wilson Rains Wilson Rains
1425 Wichita Plaza - Wichita, Kansas (Address)

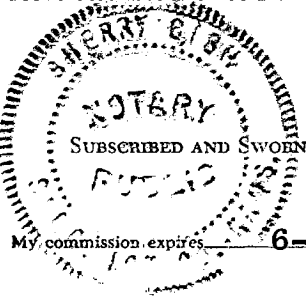

SUBSCRIBED AND SWORN to before me this 10 day of June, 19 68
Sherry Gish Notary Public