

15-051-01469-00-00

STATE OF KANSAS  
STATE CORPORATION COMMISSION  
Give All Information Completely  
Make Required Affidavit  
Mail or Deliver Report to:  
Conservation Division  
State Corporation Commission  
211 No. Broadway  
Wichita, Kansas

WELL PLUGGING RECORD

ELLIS County, Sec. 32 Twp. 11S Rge. 16W (X) (W)

Location as "NE/CNW/SW" or footage from lines SE-SW-SE

Lease Owner PETROLEUM, INC.

Lease Name CHRISLER "E" Well No. 1

Office Address ROUTE 2, GREAT BEND, KANSAS.

Character of Well (completed as Oil, Gas or Dry Hole) DRY HOLE

Date well completed FEBRUARY 9, 1962

Application for plugging filed FEBRUARY 9, 1962

Application for plugging approved FEBRUARY 9, 1962


Plugging commenced FEBRUARY 9, 1962

Plugging completed FEBRUARY 9, 1962

Reason for abandonment of well or producing formation NO PRODUCIBLE FORMATIONS

If a producing well is abandoned, date of last production NONE 19

Was permission obtained from the Conservation Division or its agents before plugging was commenced? YES

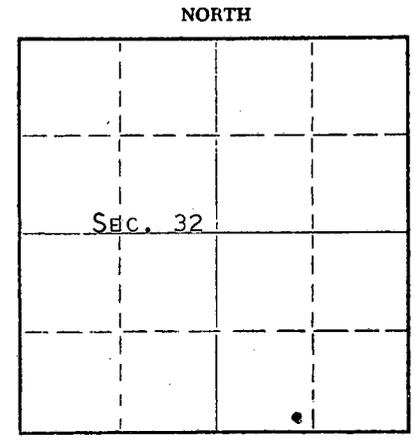

Locate well correctly on above Section Plat

Name of Conservation Agent who supervised plugging of this well ELDON PETTY

Producing formation - - - Depth to top - - Bottom - - Total Depth of Well 3150 Feet

Show depth and thickness of all water, oil and gas formations.

OIL, GAS OR WATER RECORDS

CASING RECORD

FORMATION	CONTENT	FROM	TO	SIZE	PUT IN	PULLED OUT
				8-5/8"	257'	NONE

Describe in detail the manner in which the well was plugged, indicating where the mud fluid was placed and the method or methods used in introducing it into the hole. If cement or other plugs were used, state the character of same and depth placed, from feet to feet for each plug set.

MUDDED UP WITH HEAVY MUD TO 480' FOLLOWED BY WOODEN PLUG. PLACED 20 SACKS CEMENT THROUGH DRILL PIPE ONTO PLUG. MUDDED UP WITH HEAVY MUD TO 180', FOLLOWED BY WOODEN PLUG AND 1/4 SACK HULLS. PLACED 20 SACKS CEMENT ONTO HULLS THROUGH DRILL PIPE. MUDDED UP WITH HEAVY MUD TO 35', FOLLOWED BY WOODEN PLUG, 1/2 SACK HULLS AND 10 SACKS CEMENT OT BASE OF WELL CELLAR.

RECEIVED  
STATE CORPORATION COMMISSION  
3-5-1962  
MAR 5 1962

CONSERVATION DIVISION  
Wichita, Kansas

(If additional description is necessary, use BACK of this sheet)  
Name of Plugging Contractor GARVEY DRILLING COMPANY  
Address ROUTE 2, GREAT BEND, KANSAS

STATE OF KANSAS, COUNTY OF BARTON, ss.


DON SEARLE (employee of owner) or (owner or operator) of the above-described well, being first duly sworn on oath, says: That I have knowledge of the facts, statements, and matters herein contained and the log of the above-described well as filed and that the same are true and correct. So help me God. DON SEARLE, DIST. PROD. SUPT.

(Signature) Don Searle

ROUTE 2, GREAT BEND, KANSAS (Address)

SUBSCRIBED AND SWORN TO before me this 2ND day of MARCH, 1962

My commission expires APRIL 14, 1963  
Arthur J. Jovile Notary Public.

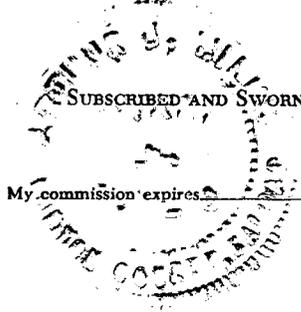

# WELL LOG 15-051-01469-00-00

COMPANY PETROLEUM, INCORPORATED

SEC. 32 T. 11S R. 16W

FARM CHRISLER "E" NO. 1


LOC. SE, SW, SE

TOTAL DEPTH 3150'

COUNTY ELLIS CO., KANSAS

COMM. February 2, 1962 COMP. February 9, 1962

CONTRACTOR GARVEY DRILLING COMPANY

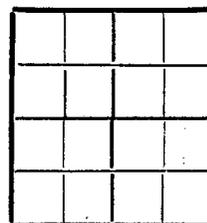

CASING 8-5/8" @ 257' w/200 sax.

ELEVATION 1845' D.F.

PRODUCTION D & A

FIGURES INDICATE BOTTOM OF FORMATIONS

40	Surface clay & sand
315	Shale
375	Anhydrite
460	Sand
570	Shale
901	Shale & sand
1075	Sand
1400	Shale
1600	Shale & shells
2035	Shale & lime
2150	Lime & shale
2365	Shale & lime
2535	Shale
2830	Shale & lime
3150	Lime
3150	T. D.

RECEIVED  
 STATE CORPORATION COMMISSION  
 3-5-1962  
 MAR 5 1962  
 CONSERVATION DIVISION  
 Wichita, Kansas

State of KANSAS }  
 County of BARTON } ss

I, VERNE A. MORRIS of GARVEY DRILLING COMPANY  
 upon oath state the above and foregoing is a true and correct copy of the log of the #1 CHRISLER well.

Subscribed and sworn to before me this 22nd day of February 19 62

My Commission Expires: April 14, 1963

*Verne A. Morris*  
 \_\_\_\_\_  
*Arthur J. Miles*  
 \_\_\_\_\_  
 NOTARY PUBLIC