


STATE OF KANSAS
STATE CORPORATION COMMISSION

15-051-01260-00-00

WELL PLUGGING RECORD

Give All Information Completely
Make Required Affidavit
Mail or Deliver Report to:
Conservation Division
State Corporation Commission
211 No. Broadway
Wichita, Kansas

NORTH

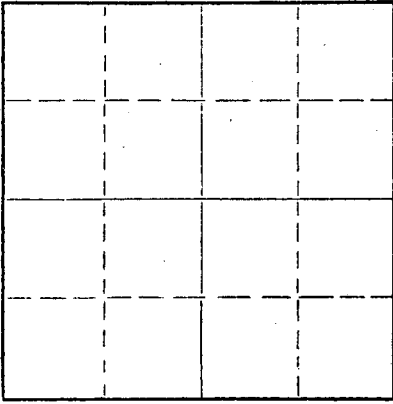

Locate well correctly on above
Section Plat

Ellis County. Sec. 36 Twp. 11S Rge. 16 (E) W (W)
Location as "NE/CNWxSWx" or footage from lines NW NW NE
Lease Owner Woodman & Iannitti Drilling Co.
Lease Name Chrisler Well No. 1
Office Address P. O. Box 387, Hoisington, Kansas
Character of Well (completed as Oil, Gas or Dry Hole) Dry Hole
Date well completed 4-28 19 57
Application for plugging filed 4-28 19 57
Application for plugging approved 4-28 19 57
Plugging commenced 4-28 19 57
Plugging completed 4-28 19 57
Reason for abandonment of well or producing formation Dry

If a producing well is abandoned, date of last production _____ 19____
Was permission obtained from the Conservation Division or its agents before plugging was commenced? Yes.

Name of Conservation Agent who supervised plugging of this well Milton Galyart (unable to reach Elden Petty)
Producing formation _____ Depth to top _____ Bottom _____ Total Depth of Well 3500 Feet
Show depth and thickness of all water, oil and gas formations.

OIL, GAS OR WATER RECORDS

CASING RECORD

| FORMATION | CONTENT | FROM | TO | SIZE | PUT IN | PULLED OUT |
|-----------|---------|------|----|--------|--------|------------|
| | | | | 8 5/8" | 941' | |
| | | | | | | |
| | | | | | | |
Describe in detail the manner in which the well was plugged, indicating where the mud fluid was placed and the method or methods used in introducing it into the hole. If cement or other plugs were used, state the character of same and depth placed, from _____ feet to _____ feet for each plug set.

Filled hole with heavy mud to 300 1/3 sack hulls - bottom plug at 300' 5 stands pickup 2' then 15 sacks cement, then heavy mud to 40'. Then 1/3 sack hulls then plug, 10 sacks cement.

STATE CORPORATION COMMISSION
4-30-1957
APR 30 1957

CONSERVATION DIVISION
Wichita, Kansas

(If additional description is necessary, use BACK of this sheet)


Name of Plugging Contractor Woodman & Iannitti Drilling Company
Address P. O. Box 387, Hoisington, Kansas

STATE OF Kansas, COUNTY OF Sedgwick, ss.
K. T. Woodman (owner or operator) of the above-described well, being first duly sworn on oath, says: That I have knowledge of the facts, statements, and matters herein contained and the log of the above-described well as filed and that the same are true and correct. So help me God.

(Signature) K. T. Woodman
717 Union Nat'l. Bldg., Wichita 2, Kansas
(Address)

SUBSCRIBED AND SWORN TO before me this 29th day of April, 1957

Mildred E. Lick, Notary Public.

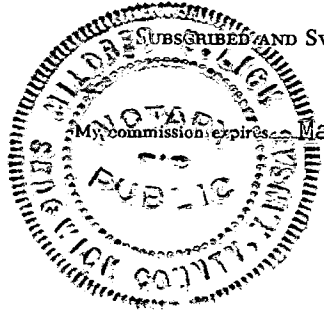

PLUGGING
FILE SEC. 36 T. 11 S. 16W
BOOK PAGE 9 LINE 34

DRILLING LOG

Company: Woodman & Iannitti Drilling Co. and Frank A. Oyster
 Lease: #1 Chrisler
 Location: NW NW NE Sec. 36-11S-16W Ellis Co., Kansas
 Contractor: Woodman & Iannitti Drilling Co., P. O. Box 387, Hoisington, Kansas
 Date Comm: 4-18-57
 Date Compl: 4-28-57
 T. D.: 3500'
 Casing: 8 5/8" at 941'

Figures Indicate the Bottom of Formation

| | | | |
|------|---------------------|------|----------------|
| 0-35 | Surface Soil | 2405 | Shale & Shells |
| 40 | Sand | 2600 | Shale & Shells |
| 58 | Shale | 2740 | Shale & Lime |
| 175 | Shale-Gravel-Sand | 2805 | Shale & Lime |
| 285 | Shale & Shells | 2860 | Shale & Lime |
| 300 | Sand & Red Bed | 2895 | Lime & Shale |
| 530 | Red Bed & Shale | 2955 | Lime & Shale |
| 870 | Red Bed & Shale | 3010 | Lime & Shale |
| 895 | Iron Pyrite & Shale | 3013 | Lime |
| 936 | Red Bed & Red Rock | 3090 | Lime |
| 941 | Anhydrite | 3100 | Lime |
| 975 | Anhydrite | 3160 | Lime |
| 1325 | Red Bed & Shale | 3225 | Lime |
| 1524 | Red Bed & Shale | 3275 | Lime & Cong. |
| 1680 | Shale & Shells | 3400 | Lime & Cong. |
| 1690 | Shale & Shells | 3461 | Conglomerate |
| 1760 | Brown Lime & Shale | 3481 | Simpson |
| 1790 | Shale & Shells | 3485 | Arbuckle |
| 1820 | Lime & Shale | 3500 | Arbuckle |
| 2020 | Lime | | |
| 2105 | Lime & Shale | | |
| 2235 | Lime & Shale | | |
| 2340 | Lime & Shale | | |

GEOLOGICAL TOPS

| | | | | |
|-----------|---------------------|---------------|------|-------|
| Elevation | 1775 RB | Conglomerate | 3314 | -1539 |
| Anhydrite | 936 / 839 (driller) | Simpson Shale | 3442 | -1667 |
| Heebner | 2962 | Arbuckle | 3474 | -1699 |
| Toronto | 2980 | Total Depth | 3500 | -1725 |
| Lansing | 3010 | | | |

I certify the above to be true and correct copy of the Driller's Log and Geological Tops to the best of knowledge and belief.

WOODMAN & IANNITTI DRILLING CO.
 BY K. T. Woodman
 K. T. Woodman

PLUGGING
 FILE SEC 36 T 11 S 16W
 BOOK PAGE 9 34

RECEIVED
 CORPORATION COMMISSION
 4-30-1957
 APR 30 1957
 CONSERVATION DISTRICT