


STATE OF KANSAS
STATE CORPORATION COMMISSION

WELL PLUGGING RECORD

Give All Information Completely
Make Required Affidavit
Mail or Deliver Report to
Conservation Division
State Corporation Comm.
245 North Water
Wichita, KS 67202

Ellis County, Sec. 3 Twp. 11S Rge. 17 ~~XX~~W
Location as "NE/CNW/SW" or footage from lines
SE NE SW
Lense Owner Liberty Enterprises, Inc.
Lease Name Simpson A Well No. #1
Office Address 308 West Mill Plainville, Kansas 67663
Character of Well (Completed as Oil, Gas or Dry Hole)

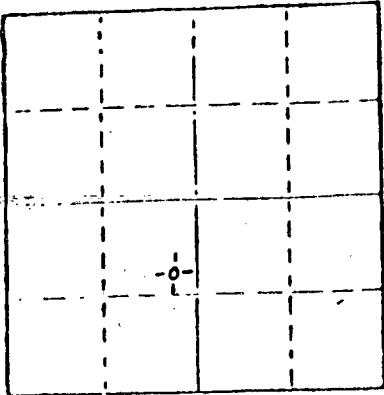

Dry Hole
Date Well completed August 14, 1980 19
Application for plugging filed August 14, 1980 19
Application for plugging approved August 14, 1980 19
Plugging commenced August 14, 1980 19
Plugging completed August 14, 1980 19
Reason for abandonment of well or producing formation
No Commercial Production
If a producing well is abandoned, date of last production 19

Was permission obtained from the Conservation Division or its agents before plugging was commenced? yes
Name of Conservation Agent who supervised plugging of this well Marion Schmidt
Producing formation / Depth to top Bottom Total Depth of Well
Show depth and thickness of all water, oil and gas formations.

OIL, GAS OR WATER RECORDS

CASING RECORD

LOCATION	CONTENT	FROM	TO	SIZE	PUT IN	PULLED OUT
surface casing	common	0	220.84'	8 5/8"	220.84'	0

Describe in detail the manner in which the well was plugged, indicating where the mud fluid was placed and the method or methods used in introducing it into the hold. If cement or other plugs were used, state the character of same and depth placed, from feet to feet for each plug set.

Plug #1 @ 690' with 70 sxs
Plug #2 @ 210' with 25 sxs
Plug #3 @ 40' with 1 sxs hulls 10sxs
5 sxs in rathole total 110 sxs
50-50 poz 6% gel
Plugdown @ 6:30 a.m.

RECEIVED
STATE CORPORATION COMMISSION
8-25-1980
AUG 25 1980

CONSERVATION DIVISION
Plainville, Kansas

(If additional description is necessary, use BACK of this sheet.)
Name of Plugging Contractor Pioneer Drilling Company, Inc. 308 West Mill Street
Plainville, Kansas 67663


STATE OF, Kansas COUNTY OF Rooks, ss.
Roger L. Comeau (employee of owner) or (owner or operator)
of the above-described well, being first duly sworn on oath, says: That I have knowledge of the facts, statements, and matters herein contained and the log of the above-described well as filed and that the same are true and correct. So help me God.

(Signature) Roger L. Comeau
308 West Mill Plainville, KS 67663
(Address)

SUBSCRIBED AND SWORN TO before me this 22nd day of August, 1980

Connie J. Austin
Notary Public.

My commission expires

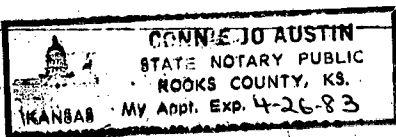

15-051-21967-00-00

WELL LOG

OPERATOR: Liberty Enterprises, Inc

WELL NAME: Simpson #1 A LOCATION: SE NE SW 3-11S-17W

COUNTY: Ellis STATE: Kansas

WELL COMMENCED: August 6, 1980 WELL COMPLETED: August 14, 1980

ELEVATION: 1895' K.B. TOTAL DEPTH: 3525'

PRODUCTION: D & A RIG NO: #1

CASING - 8-5/8": 220.84' of used 28# cemented with 110 sxs common 3% cc 2% gel cement circ
5-1/2": _____

ALL MEASUREMENTS TAKEN FROM THE TOP OF ROTARY BUSHING:

FROM	TO	FORMATION	DEVIATION FROM VERTICAL	REMARKS:
0'	229'			
229'	480'	shale and sand		
480'	1125'	sand and shale		
1125'	1139'	anhydrite		
1139'	1157'	anhydrite		
1157'	1565'	shale and redbed		
1565'	1729'	shale and redbed		
1729'	1967'	lime and shale	1729' - 3/4 degree	
1967'	2200'	shale and lime		
2200'	2467'	lime and shale		
2467'	2689'	lime and shale		
2689'	2870'	lime and shale		
2870'	2990'	lime and shale		
2990'	3072'	lime and shale		
3072'	3157'	lime and shale		
3157'	3230'	lime and shale		
3230'	3284'	lime and shale		
3284'	3365'	lime and shale		
3365'	3366'	lime and shale	3366' - 5 degrees	
3366'	3375'	lime and shale		
3375'	3418'	lime and shale	3380' - 2 3/4 degrees	
3418'	3475'	lime and shale		
3475'	3525'	lime and chert and shale		
3525'	RTD			

RECEIVED
STATE CORPORATION COMMISSION
8-25-1980
AUG. 25 1980
CONSERVATION DIVISION
Wichita, Kansas

STATE OF KANSAS
COUNTY OF _____

The undersigned hereby certifies that to the best of his knowledge and belief, the above facts are true and correct

PIONEER DRILLING CO., INC.

By Ryan J. Lomas

SUBSCRIBED AND SWORN TO, BEFORE ME, This 22nd day of Aug, 1980

Connie Jo Austin
- NOTARY PUBLIC

