


Give All Information Completely  
Make Required Affidavit  
Mail or Deliver Report to:  
Conservation Division  
State Corporation Commission  
212 No. Market  
Wichita, Kansas

WELL PLUGGING RECORD

Ellis County. Sec. 12 Twp. 11S Rge. (E) 17 (W)  
Location as "NE/CNW%SW%" or footage from lines NW NW SE  
Lease Owner Abercrombie Drilling, Inc.  
Lease Name Simpson Well No. 1  
Office Address 801 Union Center, Wichita, Kansas  
Character of Well (completed as Oil, Gas or Dry Hole) Dry Hole  
Date well completed January 27, 19 67  
Application for plugging filed (verbally) January 27, 19 67  
Application for plugging approved (verbally) January 27, 19 67  
Plugging commenced January 28, 19 67  
Plugging completed January 28, 19 67  
Reason for abandonment of well or producing formation Dry Hole

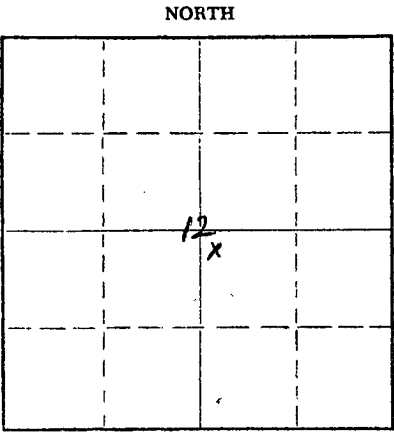

If a producing well is abandoned, date of last production \_\_\_\_\_ 19 \_\_\_\_  
Was permission obtained from the Conservation Division or its agents before plugging was commenced? Yes, verbally

Name of Conservation Agent who supervised plugging of this well Leo Massey  
Producing formation \_\_\_\_\_ Depth to top \_\_\_\_\_ Bottom \_\_\_\_\_ Total Depth of Well 3328 Feet  
Show depth and thickness of all water, oil and gas formations.

OIL, GAS OR WATER RECORDS

CASING RECORD

FORMATION	CONTENT	FROM	TO	SIZE	PUT IN	PULLED OUT
				7"	964'	None

Describe in detail the manner in which the well was plugged, indicating where the mud fluid was placed and the method or methods used in introducing it into the hole. If cement or other plugs were used, state the character of same and depth placed, from \_\_\_\_\_ feet to \_\_\_\_\_ feet for each plug set.

Filled hole with heavy mud to 300 feet. First plug at 300 feet with 1/2 sack of hulls and 25 sacks of cement. Filled hole with heavy mud to 40 feet. Second plug at 40 feet, with 1/2 sack of hulls and 8 sacks of cement. Two sacks of cement in rat hole.


RECEIVED  
STATE CORPORATION COMMISSION  
FEB 7 1967  
2-7-1967  
CONSERVATION DIVISION  
Wichita, Kansas

(If additional description is necessary, use BACK of this sheet)  
Name of Plugging Contractor Abercrombie Drilling, Inc.  
Address West Tenth Street, Great Bend, Kansas

STATE OF KANSAS, COUNTY OF SEDGWICK, ss. Jack K. Wharton (employee of owner) or (owner or operator) of the above-described well, being first duly sworn on oath, says: That I have knowledge of the facts, statements, and matters herein contained and the log of the above-described well as filed and that the same are true and correct. So help me God.

(Signature) Jack K. Wharton  
801 Union Center, Wichita, Kansas  
(Address)

SUBSCRIBED AND SWORN to before me this 3rd day of February, 19 67  
My commission expires March 31, 1970.  
Margo Dee Montgomery  
Notary Public.

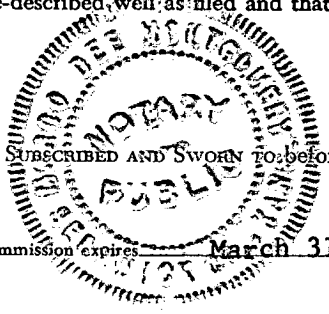

CONTRACTOR'S WELL LOG

COMPANY: Abercrombie Drilling, Inc.  
 CONTRACTOR: Abercrombie Drilling, Inc.  
 FARM: Simpson No. 1  
 LOCATION: NW NW SE, Sec. 12-11S-17W  
 Ellis County, Kansas  
 COMMENCED: January 19, 1967  
 COMPLETED: January 28, 1967

0	115	Sand
115	690	Shale, Sand & Shells
690	960	Shells, Shale & Red Beds
960	1002	Anhydrite
1002	1540	Shells, Shale & Lime
1540	1835	Shale with Lime Streaks
1835	2010	Lime
2010	2230	Shale & Lime
2230	2420	Lime & Shale
2420	2645	Shale & Lime
2645	2760	Shale
2760	2865	Lime & Shale
2865	2977	Shale & Lime
2977	3037	Lime & Shale
3037	3135	Shale & Lime
3135	3197	Lime & Shale
3197	3211	Shale & Lime
3211	3215	Lime
3215	3275	Lime & Shale
3275	3328	Chert & Lime
	3328	Total Depth

RECEIVED  
 STATE CORPORATION COMMISSION  
 2-7-1967  
 FEB 7 1967  
 CONSERVATION DIVISION  
 Wichita, Kansas

7" Surface Casing was set at 964 feet with 275 sacks of cement.

Dry and Abandoned

<u>FORMATION TOPS:</u>		<u>ELEVATION:</u>	
Heebner	2926	(-1147)	1779 K.B.
Toronto	2947	(-1168)	1778 D.F.
Lansing	2969	(-1190)	1772 G.L.
B/K.C.	3210	(-1431)	
Conglomerate	3237	(-1458)	
T.D.	3328	(-1549)	

STATE OF KANSAS )  
 ) SS  
 COUNTY OF SEDGWICK )

I, Mildred Saxton, do hereby certify that the above and foregoing is a true and correct copy of the log of the Simpson #1, NW NW SE of Section 12-11S-17W, Ellis County, Kansas, as reflected by the files of Abercrombie Drilling, Inc.

*Mildred Saxton*  
 Mildred Saxton  
 Secretary

Subscribed and sworn to before me, a Notary Public, in and for Sedgwick County, Kansas, as of January 31, 1967.

*Margie Dee Montgomery*  
 Margie Dee Montgomery  
 Notary Public

My commission expires March 31, 1970