


15-051-03550-00-00

WELL PLUGGING RECORD

Give All Information Completely
Make Required Affidavit
Mail or Deliver Report to:
Conservation Division
State Corporation Commission
800 Biting Building
Wichita, Kansas

NORTH

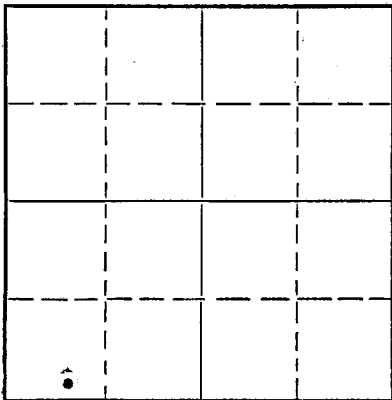

Locate well correctly on above
Section Plat

Ellis County, Sec. 19 Twp. 11 Rge. 20W (E) (W)

Location as "NE/CNW $\frac{1}{4}$ SW $\frac{1}{4}$ " or footage from lines SE SW NW

Lease Owner Imperial Drilling Company, Inc.

Lease Name Vance "A" Well No. 2

Office Address 903 Union Nat'l. Bank Bldg., Wichita, Kans.

Character of Well (completed as Oil, Gas or Dry Hole) Dry Hole

Date well completed May 12 1953

Application for plugging filed May 12 1953

Application for plugging approved May 13 1953

Plugging commenced May 13 1953

Plugging completed May 13 1953

Reason for abandonment of well or producing formation oil in commercial quantities not found.

If a producing well is abandoned, date of last production 19

Was permission obtained from the Conservation Division or its agents before plugging was commenced? yes

Name of Conservation Agent who supervised plugging of this well Eldon Petty, Hays, Kansas

Producing formation Depth to top Bottom Total Depth of Well 3840' Feet

Show depth and thickness of all water, oil and gas formations.

OIL, GAS OR WATER RECORDS

CASING RECORD

Formation	Content	From	To	Size	Put In	Pulled Out
				8 5/8"	228'	none

Describe in detail the manner in which the well was plugged, indicating where the mud fluid was placed and the method or methods used in introducing it into the hole. If cement or other plugs were used, state the character of same and depth placed, from feet to feet for each plug set.

Set #1 plug at 210' with 15 sacks cement. Filled Hole with Rotary mud to 40'. Set #2 plug with 10 sacks cement.

RECEIVED
STATE CORPORATION COMMISSION
MAY 19 1953
CONSERVATION DIVISION
Wichita, Kansas

(If additional description is necessary, use BACK of this sheet)

Name of Plugging Contractor Imperial Drilling Company, Inc.

Address 903 Union National Bank Bldg., Wichita 2, Kansas

STATE OF KANSAS, COUNTY OF SEDGWICK, ss.

Raymond L. Bacon (employee of owner) or (owner) of the above-described well,

being first duly sworn on oath, says: That I have knowledge of the facts, statements, and matters herein contained and the log of the above-described well as filed and that the same are true and correct. So help me God. IMPERIAL DRILLING COMPANY, INC.

(Signature) By: Raymond L. Bacon Vice-Pres.

903 Union National Bank Building
Wichita, Kansas (Address)

SUBSCRIBED AND SWORN to before me this 18th day of May, 1953

My commission expires Jan. 4, 1954

Marquette Little
Notary Public.

PLUGGING
MAY 19 1953
PAGE 164 UNIT 26

15-051-03550-00-00

DRILLER'S LOG

Imperial Drilling Company, Inc.
903 Union National Bank Building
Wichita, Kansas

Vance "A" #2
SE SW NW 19-11S-20W
Ellis County, Kansas

Total Depth: 3840'

Elevation: 2184 R.B.

Commenced: 5-1-53

Completed: 5-12-53

Production: D & A

Contractor: Imperial Drilling Company, Inc.
903 Union National Bank Building
Wichita, Kansas

Casing Record: Set 228' of 8 5/8" surface casing with 150 sacks cement.

Figures indicate bottom of formations:

Surface Rock, Sand & Clay	185'
Shale & Shells	228'
Clay & Shells	850'
Shells & Sand	1090'
Dakota Sand	1310'
Shale & Shells	1595'
Anhydrite	1645'
Shale & Shells	2245'
Shale & Lime	2605'
Shell & Lime	2705'
Lime & Shale	3440'
Lime	3840'
Total Depth	3840'

TOPS:

Elevation	2184 R.B.
Anhydrite	1595' (/ 589)
Topeka	3216' (-1031)
Heebner	3434' (-1250)
Lansing	3471' (-1287)
Conglomerate	3760' (-1576)
Total Depth in Congl.	3840' (-1656)

RECEIVED
STATE CORPORATION COMMISSION
5-19-1953
MAY 19 1953

We hereby certify this to be a correct and accurate log of the above described well as shown on the daily drilling reports.

IMPERIAL DRILLING COMPANY, INC.

By: Ray L. Brown
Vice-President

Subscribed and sworn to before me this 18th day of May, 1953.

Maguire J. Hill
Notary Public

My Commission Expires:

Jan. 4, 1954

PLUGGING
FILE SEC 19 T 11 R 20W
BOOK PAGE 101 LINE 26