


Give All Information Completely  
Make Required Affidavit  
Mail or Deliver Report to:  
Conservation Division  
State Corporation Commission  
800 Bittling Building  
Wichita, Kansas

15-057-00802-00-00  
WELL PLUGGING RECORD

NORTH

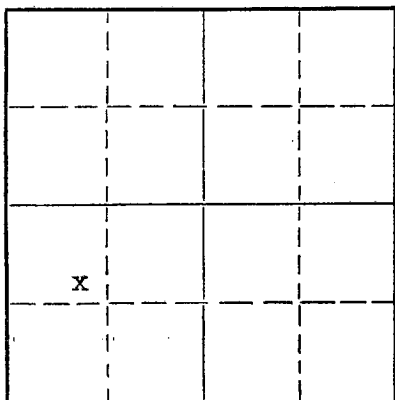

Locate well correctly on above  
Section Plat

Ellis County. Sec. 20 Twp. 11 Rge. (E) 20 (W)  
Location as "NE/CNW/SW" or footage from lines SE NW SW  
Lease Owner Chas. Hulme Drilling Contractor  
Lease Name Thayer Well No. 1  
Office Address P.O. Box 36, Great Bend, Kansas  
Character of Well (completed as Oil, Gas or Dry Hole) Dry Hole  
Date well completed August 21 1956  
Application for plugging filed August 23 1956  
Application for plugging approved Verbal Permission August 21 1956  
Plugging commenced August 21 1956  
Plugging completed August 21 1956  
Reason for abandonment of well or producing formation Dry Hole

If a producing well is abandoned, date of last production 19  
Was permission obtained from the Conservation Division or its agents before plugging was commenced? Yes

Name of Conservation Agent who supervised plugging of this well Eldon Petty  
Producing formation Depth to top Bottom Total Depth of Well 3937 Feet  
Show depth and thickness of all water, oil and gas formations.

OIL, GAS OR WATER RECORDS


CASING RECORD

FORMATION	CONTENT	FROM	TO	SIZE	PUT IN	PULLED OUT
				8 5/8"	206'	-0-

Describe in detail the manner in which the well was plugged, indicating where the mud fluid was placed and the method or methods used in introducing it into the hole. If cement or other plugs were used, state the character of same and depth placed, from feet to feet for each plug set.

First set plug at 200', cemented 15 sacks.

Cemented 10 sax 40' to surface

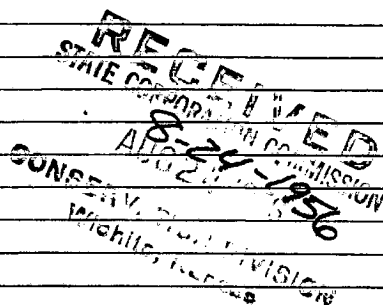

(If additional description is necessary, use BACK of this sheet)

Name of Plugging Contractor Chas. Hulme Drilling Contractor  
Address P.O. Box 36, Great Bend, Kansas

STATE OF Kansas, COUNTY OF Barton, ss.  
C. E. Byars (employee of owner) or (owner or operator) of the above-described well, being first duly sworn on oath, says: That I have knowledge of the facts, statements, and matters herein contained and the log of the above-described well as filed and that the same are true and correct. So help me God.

(Signature) C. E. Byars  
P.O. Box 36, Great Bend, Kansas (Address)

SUBSCRIBED AND SWORN TO before me this 23 day of August, 1956

My commission expires October 15, 1957

Notary Public.

PLUGGING  
FILE SEC 20 T 11 R 20W  
BOOK PAGE 92 LINE 31

15-051-00802-00-00

D R I L L E R S   L O G

THAYER #1

Location: SE NW SW

Elevation: 2259' D.F.

Section: 20-11S-20W, Ellis County, Kansas

Casing: 206' 8 5/8"

Operator: Chas. Hulme Drilling Contractor

Commenced: August 6, 1956

Contractor: Chas. Hulme Drilling Contractor

Completed: August 21, 1956

Total Depth: 3937'

From	To	Formation
0	199	Shale and Sand
199	820	Shale
820	1350	Sand
1350	1490	Shale and Shells
1490	1715	Shale
1715	1750	Anhydrite Lime
1750	1755	Lime
1755	2310	Shale
2310	2625	Shale and Lime
2625	2705	Lime
2705	3005	Lime and Shale
3005	3390	Shale and Lime
3390	3881	Lime
3881	3937	Conglomerate
3937		T.D.

State of Kansas )  
County of Barton)

ss.

I hereby certify that the above is a true and correct copy of the log on the Thayer #1 well located SE NW SW, Section 20, 11S, 20W, Ellis County, Kansas.

C. E. Byars  
C. E. Byars

Subscribed and sworn to before me this 23rd day of August, 1956.

Notary Public

My Commission Expires: October 15, 1957

PLUGGING  
FILE SEC. 20 T. 11 R. 20W  
BOOK PAGE 92 LINE 31