

State

15-051-23612-00-00


STATE OF KANSAS
STATE CORPORATION COMMISSION
200 Colorado Derby Bldg.
Wichita, Kansas 67202

Form CP-4
Rev. 12-15-80

WELL PLUGGING RECORD

Give All Information Completely
Make Required Affidavit

COUNTY ELLIS SEC. 22 TWP. 11S RGE. 20W E/W
Location as in quarters or footage from lines:
NW SE SE

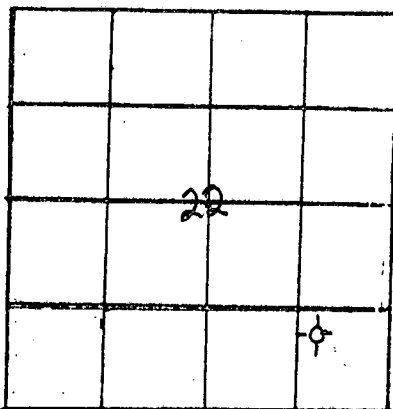

Lease Owner Chief Drilling Co., Inc.
Lease Name Fenton Well No. #1
Office Address 905 Century Plaza Wichita, Ks. 67202
Character of Well (Completed as Oil, Gas or Dry Hole): D.H.
Date Well Completed 10-04-83
Application for plugging filed 10-04-83
Plugging commenced 10-04-83
Plugging completed 10-04-83
Reason for abandonment of well or producing formation _____

Locate Well
correctly on above
Section Platt.

Was permission obtained from the Conservation Division or it's
Agent's before plugging was commenced? yes

Name of Conservation Agent who supervised plugging of this well Gilbert Scheck
Producing formation _____ Depth to top _____ bottom _____ T.D. 3800' RTD
Show depth and thickness of all water, oil and gas formations.

OIL, GAS OR WATER RECORDS

Casing Record

Formation	Content	From	To	Size	Put in	Pulled Out
Surface	6 jts. new	8 5/8"	casing	241'	set @ 244'	

Describe in detail the manner in which the well was plugged, indicating where the mud
fluid was placed and the method or methods used in introducing it into the hold. If cement
or other plugs were used, state the character of same and depth placed, from _____ feet
to _____ feet for each plug set.

Plugged w/160 sx. 50-50 pos mix, 6% gel, 3% c.c., 1st plug
@ 1500', w/20 sx., 2nd plug @ 720' w/80 sx., 3rd plug @ 300'
w/40 sx., solid bridge plug @ 40' w/10 sx., 10 sx., in the
rat hole, Started @ 11:00 a.m. Finished @ 12:30 p.m. State
Plugging = Gilbert Scheck

RECEIVED
STATE CORPORATION COMMISSION


OCT 7 1983
10-7-1983
CONSERVATION DIVISION
Wichita, Kansas

(If additional description is necessary, use BACK of this sheet)
Name of Plugging Contractor Warrior Drilling CO., Rig #1

STATE OF Kansas COUNTY OF Sedgwick, ss.
F.W. Shelton, Jr. (employee of owner) or ~~(owner or operator)~~ of the
above-described well, being first duly sworn on oath, says: That I have knowledge of the
facts, statements, and matters herein contained and the log of the above-described well as
filed and that the same are true and correct. So help me God.

(Signature) F.W. Shelton, Jr.
F.W. Shelton, Jr., Vice Pres.
(Address)

SUBSCRIBED AND SWORN TO before me this 4th day of October, 1983

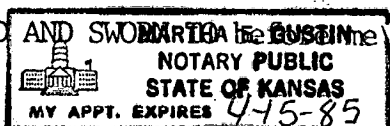

905 Century Plaza Wichita, Ks 67202
Martha E. Gustin
Martha E. Gustin Notary Public.

My Commission expires: _____