


Give All Information Completely
Make Required Affidavit
Mail or Deliver Report to:
Conservation Division
State Corporation Commission
212 No. Market
Wichita, Kansas

WELL PLUGGING RECORD

NORTH

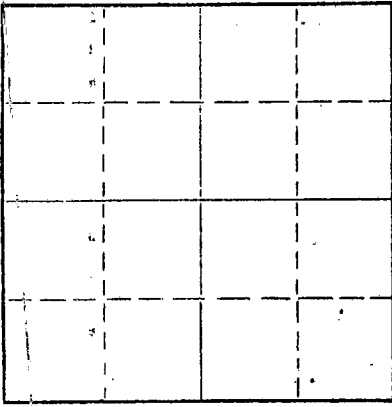

Locate well correctly on above
Section Plat

Trego County, Sec. 15 Twp. 11 Rge. 21 (E) W (W)

Location as "NE/CNWxSWx" or footage from lines NE-NE-SE
Lease Owner Leo J. Dreiling Oil Company
Lease Name V. Walker Well No. 1
Office Address Victoria, Kansas 67671
Character of Well (completed as Oil, Gas or Dry Hole) Dry Hole
Date well completed 6-8 19 67
Application for plugging filed 6-8 19 67
Application for plugging approved 6-8 19 67
Plugging commenced 6-8 19 67
Plugging completed 6-8 19 67
Reason for abandonment of well or producing formation Dry Hole

If a producing well is abandoned, date of last production 19
Was permission obtained from the Conservation Division or its agents before plugging was commenced? Yes

Name of Conservation Agent who supervised plugging of this well Bill Nichols
Producing formation _____ Depth to top _____ Bottom _____ Total Depth of Well _____ Feet
Show depth and thickness of all water, oil and gas formations.

OIL, GAS OR WATER RECORDS

CASING RECORD

FORMATION	CONTENT	FROM	TO	SIZE	PUT IN	PULLED OUT
Surface Pipe				8 5/8"	161'	

Describe in detail the manner in which the well was plugged, indicating where the mud fluid was placed and the method or methods used in introducing it into the hole. If cement or other plugs were used, state the character of same and depth placed, from _____ feet to _____ feet for each plug set.

Filled hole with rotary mud to a depth of 540' where 1st. plug was set using 20 sacks cement. Filling hole with rotary mud to a depth of 180' where 2nd. plug was set using 20 sacks cement. Rotary mud was used to fill hole to a depth of 40' where 3rd. plug was set using 10 sacks cement and filling hole to surface.

RECEIVED
STATE CORPORATION COMMISSION
6-13-1967
JUN 13 1967

CONSERVATION DIVISION
Wichita, Kansas


(If additional description is necessary, use BACK of this sheet)

Name of Plugging Contractor L. J. Dreiling & Sons, Inc.
Address Route 2, Victoria, Kansas 67671

STATE OF KANSAS COUNTY OF ELLIS, ss.
I, Leo F. Dreiling (employee of owner) or (~~owner~~) of the above-described well, being first duly sworn on oath, says: That I have knowledge of the facts, statements, and matters herein contained and the log of the above-described well as filed and that the same are true and correct. So help me God.

(Signature) Leo F. Dreiling
LEO F. DREILING, ROUTE 2, VICTORIA, KANSAS
(Address)

SUBSCRIBED AND SWORN TO before me this 12th day of June, 19 67

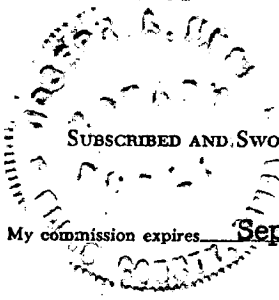

Joseph A. Hess
Joseph A. Hess Notary Public.

15-195-20022-00-00

L. J. DREILING and SONS, Inc.

VICTORIA, KANSAS

WELL LOG

Company	Lee J. Dreiling Oil Company	Sec. 15	Twp. 11	Rng. 21
	Victoria, Kansas			
Farm	V. Walker	No. 1	Location	NE-NE-SE
Total Depth	3885'		County	Trego
Comm.	6-2-67	Comp. 6-8-67	Elevation:	2234' K.B. 2231' D.F.
Contractor	L. J. Dreiling & Sons, Inc.			2229' G.R.
	Victoria, Kansas			
	Casing Record	Cement Record	Production:	D & A
	161' 8 5/8"	135 sacks cement		

Figures Indicate Bottom of Formations

0'	90'	Sand
90'	161'	Shale
161'	740'	Shale
740'	940'	Sand
940'	1020'	Shale & Shells
1020'	1450'	Shale & Shells
1450'	1677'	Redbed & Shale
1677'	1724'	Anhy.
1724'	1750'	Shale & Shells
1750'	2250'	Shale & Shells & Salt
2250'	2315'	Shale & Lime Streaks
2315'	2330'	Shale & Lime Streaks
2330'	2553'	Lime & Shale Streaks
2553'	2790'	Lime & Shale Streaks
2790'	2980'	Shale & Lime
2980'	3233'	Shale & Lime
3233'	3423'	Lime & Shale Streaks
3423'	3483'	Lime Cherty
3483'	3600'	Lime
3600'	3664'	Lime
3664'	3755'	Lime
3755'	3792'	Lime
3792'	3846'	Lime
3846'	3868'	Lime
3868'	3885'	Lime
3885'	T.D.	

RECEIVED
 JUN 13 1967
 COMMISSIONER OF REVENUE
 STATE OF KANSAS

STATE OF KANSAS)
)ss
 COUNTY OF ELLIS)

I, Leo F. Dreiling, of the L. J. Dreiling & Sons, Inc. upon oath states that the above and foregoing is a true and correct copy from the Daily Drilling Report from your V. Walker #1.

Leo F. Dreiling
 LEO F. DREILING

Subscribed and sworn to before me this 12th day of June 1967.

Joseph A. Hess
 JOSEPH A. HESS NOTARY PUBLIC

My commission expires: September 19, 1970