

15-195-00496-00-00


WELL PLUGGING RECORD

FORMATION PLUGGING RECORD

Strike out upper line when reporting plugging off formations.

STATE OF KANSAS STATE CORPORATION COMMISSION

Give All Information Completely Make Required Affidavit Mail or Deliver Report to: Conservation Division State Corporation Commission 800 Bittling Building Wichita, Kansas

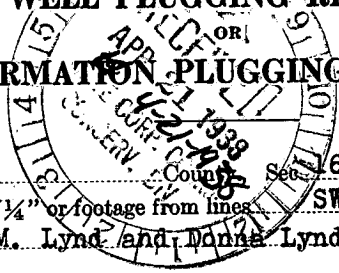

Trego

County 6 Twp. 11S Rge. (E) 21 (W)

Location as "NE 1/4 NW 1/4 SW 1/4" or footage from lines

Lease Owner Miles M. Lynd and Donna Lynd

Lease Name Lynd Well No. 1

Office Address Ellis, Kansas

Character of Well (Completed as Oil, Gas or Dry Hole) Dry Hole

Date, well completed March 24 1938

Application for plugging filed March 21 1938

Application for plugging approved March 24 1938


Plugging Commenced March 26 1938

Plugging Completed March 26 1938

Reason for abandonment of well or producing formation Dry Hole

If a producing well is abandoned, date of last production 193

Was permission obtained from the Conservation Division or its agents before plugging was commenced? Yes

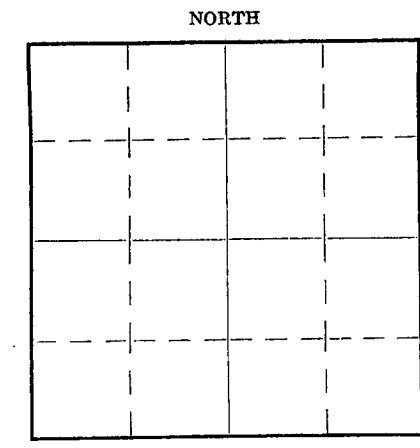

Locate well correctly on above Section Plat

Name of Conservation Agent who supervised plugging of this well Ed Sheil

Producing formation Depth to top Bottom Total Depth of Well 4057 Feet

Show depth and thickness of all water, oil and gas formations.


OIL, GAS OR WATER RECORDS

CASING RECORD

Table with 7 columns: Formation, Content, From, To, Size, Put In, Pulled Out. Contains data for 15" and 10" casing.

Describe in detail the manner in which the well was plugged, indicating where the mud fluid was placed and the method or methods used in introducing it into the hole. If cement or other plugs were used, state the character of same and depth placed, from feet to feet for each plug set.

15 feet of cement plug at 250 feet and 15 feet of cement plug at bottom of cellar.

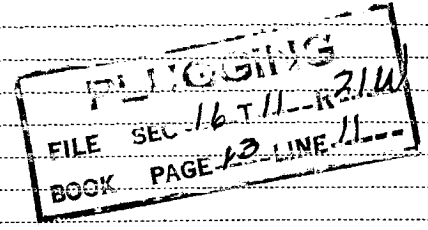

(If additional description is necessary, use BACK of this sheet)

Correspondence regarding this well should be addressed to Manning & Martin, Inc. Address 315 Continental Oil Building, Denver, Colorado.

STATE OF Colorado COUNTY OF Denver ss. C. D. Martin

(employee of owner) or (owner or operator) of the above-described well, being first duly sworn on oath, says: That I have knowledge of the facts, statements, and matters herein contained and the log of the above-described well as filed and that the same are true and correct. So help me God.

(Signature) Fred Manning

Vice President, MANNING & MARTIN, Inc. Denver, Colorado

SUBSCRIBED AND SWORN to before me this 19 day of April, 1938

My commission expires Oct. 13, 1946

Blaine Foster Notary Public

