

STATE OF KANSAS
STATE CORPORATION COMMISSION


15-195-00017-00-00

WELL PLUGGING RECORD

Give All Information Completely
Make Required Affidavit
Mail or Deliver Report to:
Conservation Division
State Corporation Commission
800 Bitting Building
Wichita, Kansas

Trego County, Sec. 17 Twp 11S Rge. 21 (E) W (W)

Location as "NE/CNW $\frac{1}{4}$ SW $\frac{1}{4}$ " or footage from lines SE SE SW
Lease Owner Aurora Gasoline Company
Lease Name Osborn "A" Well No. 1
Office Address 308 Wright Bldg., Tulsa, Oklahoma
Character of Well (completed as Oil, Gas or Dry Hole) Dry
Date well completed Jan. 28 19 52
Application for plugging filed Jan. 28 19 52
Application for plugging approved Jan. 28 19 52
Plugging commenced Jan. 28 19 52
Plugging completed Jan. 28 19 52
Reason for abandonment of well or producing formation Dry

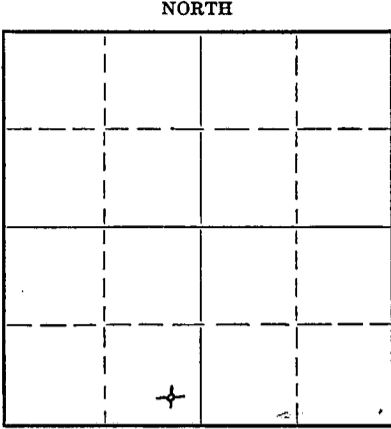

Locate well correctly on above Section Plat

If a producing well is abandoned, date of last production 19
Was permission obtained from the Conservation Division or its agents before plugging was commenced? Yes

Name of Conservation Agent who supervised plugging of this well Eldon Petty
Producing formation Depth to top Bottom Total Depth of Well Feet
Show depth and thickness of all water, oil and gas formations.

OIL, GAS OR WATER RECORDS

CASING RECORD

Formation	Content	From	To	Size	Put In	Pulled Out
		0	146'	8 5/8"	146'	none

Describe in detail the manner in which the well was plugged, indicating where the mud fluid was placed and the method or methods used in introducing it into the hole. If cement or other plugs were used, state the character of same and depth placed, from feet to feet for each plug set.

From 3986' to 145' - Heavy Rotary Mud
145' to 144' - Wooden Plug
144' to 139' - $\frac{1}{2}$ sack hulls
139' to 93' - 15 sacks cement
93' to 40' - Heavy rotary mud
40' to 39' - Wooden plug
39' to 34' - $\frac{1}{2}$ sack hulls
34' to 6' - 10 sacks cement
6' to Surface - Cellar

(If additional description is necessary, use BACK of this sheet)

Name of Plugging Contractor Glenn W. Peel
Address P. O. Box 359, Hoisington, Kansas

STATE OF Kansas, COUNTY OF Barton, ss.
Glenn W. Peel (employee of owner) or OWNER/OPERATOR of the above-described well,

being first duly sworn on oath, says: That I have knowledge of the facts, statements, and matters herein contained and the log of the above-described well as filed and that the same are true and correct. So help me God.

BY: *Glenn W. Peel*
(Signature) P. O. BOX 359
HOISINGTON, KANSAS
(Address)

SUBSCRIBED AND SWORN TO before me this 30th day of January, 1952
Marion M. Herbert
Notary Public.

My commission expires June 4, 1955

23-8390-s 6-51-20M. FEB 1 X 1952

PLUGGING
FILED REC 17 11 21W
DATE 14 1952

15-195-00017-00-00

DRILLERS LOG

Company: Aurora Gasoline Co.

SE SE SW

Farm Name: Osborn "A" Well No. 1

Sec. 17, Twp. 11S, Rge 21W,

Total Depth: 3986'

County: Trego,
Kansas

Comm: 1-18-52 Comp: 1-28-52

Elevation:

Contractor: Glenn W. Peel

Production: Dry

Casing: 8 5/8" 146' cem.

Figures below indicate bottom of formations

Clay and sand	0 -	70
Shale and shells		146
Shale and sand		1425
Shale		1760
Anhydrite		1795
Shale		1935
Shale and Shells		2450
Shale and Lime		2510
Lime		2700
Lime and shale		2815
Lime		2925
Lime and Shale		3155
Lime		3915
Lime and chert		3955
Lime		3986
Total Depth		3986

This is to certify that the above information is, to the best of our knowledge true and correct.

GLENN W. PEEL

BY: *Glenn W. Peel*

SUBSCRIBED AND SWORN to before me this 30th day of January, 1952.

My commission expires June 4, 1955

Marion M. Herbert
Notary Public

