


15-167-22064-00-00

STATE OF KANSAS
STATE CORPORATION COMMISSION

WELL PLUGGING RECORD

Give All Information Completely
Make Required Affidavit
Mail or Deliver Report to
Conservation Division
State Corporation Comm.
245 North Water
Wichita, KS 67202

Russell County, Sec. 31 Twp. 11 Rge. 12 E/W
Location as "NE/CNW/SW" or footage from lines

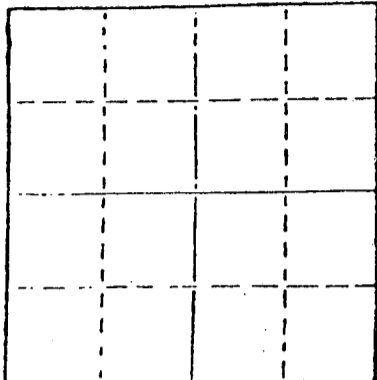

Locate well correctly on above Section Plat

NE NW NW
Lease Owner Shields Oil Producers, Inc.
Lease Name Strecker Well No. 5
Office Address Shields Bldg., Russell, Kansas 67665
Character of Well (Completed as Oil, Gas or Dry Hole)

Dry Hole

Date Well completed 2-23 19 83
Application for plugging filed " 19 83
Application for plugging approved " 19 83
Plugging commenced " 19 83
Plugging completed " 19 83
Reason for abandonment of well or producing formation

If a producing well is abandoned, date of last production 19

Was permission obtained from the Conservation Division or its agents before plugging was commenced? Yes

Name of Conservation Agent who supervised plugging of this well Gilbert Scheck
Producing formation Depth to top Bottom Total Depth of Well 3,100
Show depth and thickness of all water, oil and gas formations.

OIL, GAS OR WATER RECORDS

CASING RECORD

FORMATION	CONTENT	FROM	TO	SIZE	PUT IN	PULLED OUT
				8 5/8"	449'	Cmtd w/250 sax

Describe in detail the manner in which the well was plugged, indicating where the mud fluid was placed and the method or methods used in introducing it into the hold. If cement or other plugs were used, state the character of same and depth placed, from feet to feet for each plug set.

- Fill hole w/heavy mud
- Push bridge plug to 740'
- Spotted 80 sax cement on plug thru 4 1/2" drill pipe
- Push bridge plug to 500'
- Spotted 40 sax cement on plug thru 4 1/2" drill pipe
- Push bridge plug to 40'w/ 1/2 sax hulls on plug
- Dump 10 sax cement on plug to cellar
- Dump 10 sax cement in mouse hole
- Dump 10 sax cement in rat hole

(If additional description is necessary, use BACK of this sheet)


Name of Plugging Contractor Shields Drilling Co., Inc.

STATE OF Kansas COUNTY OF Russell, ss.
Jack P. Beeman (employee of owner) or
of the above-described well, being first duly sworn on oath, says: That I have knowledge of the facts, statements, and matters herein contained and the log of the above-described well as filed and that the same are true and correct. So help me God.

(Signature) Jack P. Beeman
Shields Bldg., Russell, Kansas 67665
(Address)

SUBSCRIBED AND SWORN TO before me this 3rd day of March, 1983

My commission expires

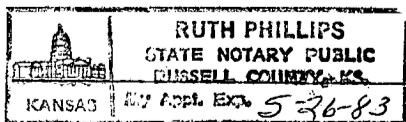

Ruth Phillips
Notary Public.

RECEIVED
STATE CORPORATION COMMISSION

MAR 7 1983
03-07-1983
CONSERVATION DIVISION
Wichita, Kansas