

STATE OF KANSAS
STATE CORPORATION COMMISSION

WELL PLUGGING RECORD

Give All Information Completely
Make Required Affidavit
Mail or Deliver Report to
Conservation Division
State Corporation Comm.
245 North Water
Wichita, KS 67202

Russell County. Sec. 14 Twp. 11S Rge. 15W E/W
Location as "NE/CNW/SW" or footage from lines

NE NE SE

Lease Owner Benson Mineral Group, Inc.

Lease Name Godfred-Miller Well No. 1

Office Address 1400 Metro Bank Building, 475 17th Denver

Character of Well (Completed as Oil, Gas or Dry Hole) 80202

Dry Hole

Date Well completed 12/21/77 19

Application for plugging filed 12/21/77 19

Application for plugging approved 12/21/77 19

Plugging commenced 12/21/77 19

Plugging completed 12/21/77 19


Reason for abandonment of well or producing formation

Dry Hole

If a producing well is abandoned, date of last production

19

Was permission obtained from the Conservation Division or
its agents before plugging was commenced? Dry Hole

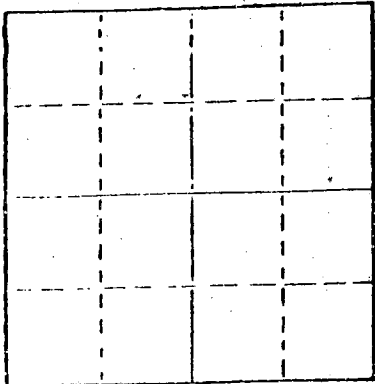

Locate well correctly on above
Section Plat

Name of Conservation Agent who supervised plugging of this well Duane Rankin
Producing formation _____ Depth to top _____ Bottom _____ Total Depth of Well 2900
Show depth and thickness of all water, oil and gas formations.

OIL, GAS OR WATER RECORDS

CASING RECORD

FORMATION	CONTENT	FROM	TO	SIZE	PUT IN	PULLED OUT

Describe in detail the manner in which the well was plugged, indicating where the mud fluid
was placed and the method or methods used in introducing it into the hold. If cement or other
plugs were used, state the character of same and depth placed, from _____ feet to
_____ feet for each plug set.

Drilling mud to 480', hull plug, 30 sx cement, mud to 240', hull plug, hull plug,
mud to 40', hull plug, 10 sx cement, 2 sx cement at rathole, 2 sx cement at
mousehole to surface.

RECEIVED
STATE CORPORATION COMMISSION
JAN 25 1978
CONSERVATION DIVISION
Wichita, Kansas

(If additional description is necessary, use back of this sheet)

Name of Plugging Contractor B & N Drilling Co., Division of Benson Mineral Group, Inc.
Box 846, Independence, Ks. 67301

STATE OF KANSAS COUNTY OF MONTGOMERY, ss.

Lucille Shukers

(employee of owner) or ~~XXXXXXXXXXXX~~

of the above-described well, being first duly sworn on oath, says: That I have knowledge of
the facts, statements, and matters herein contained and the log of the above-described well
as filed and that the same are true and correct. So help me God.

(Signature) Lucille Shukers

Box 846, Independence, Ks. 67301
(Address)

SUBSCRIBED AND SWORN TO before me this 21 day of December, 19 77

My commission expires 5/7/80 9-24-78

Jane McNickle
Notary Public.
JANE McNICKLE
NOTARY
PUBLIC
Montgomery County, Kansas

KANSAS DRILLERS LOG

API No. 15 — 167 — 21106-00-00
 County Number

S. 14 T. 11S R. 15W
 W

Loc. NE NE SE

County Russell

Operator

Benson Mineral Group, Inc.

Address

1400 Metro Bank Building, Denver, Colorado 80202

Well No.

1

Lease Name

Godfred Miller

Footage Location

feet from (N) (S) line

feet from (E) (W) line

Principal Contractor

B & N Drilling Co.

Geologist

Spud Date

12/15/77

Total Depth


2900

P.B.T.D.

Date Completed

12/21/77

Oil Purchaser

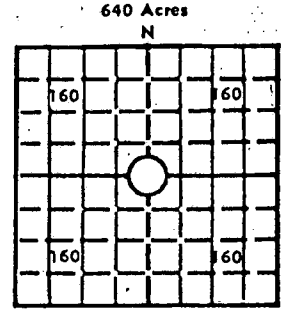

Elev.: Gr. _____

DF _____ KB _____

CASING RECORD

Report of all strings set — surface, intermediate, production, etc.

Purpose of string	Size hole drilled	Size casing set (in O.D.)	Weight lbs/ft.	Setting depth	Type cement	Sacks	Type and percent additives
Surface	9-7/8"	7"		233	Common	125	3% CC. 2% Gel
Production	6 1/4"	None	Dry Hole				
Plugged & abandon on 12/21/77							

LINER RECORD

PERFORATION RECORD

Top, ft.	Bottom, ft.	Sacks cement	Shots per ft.	Size & type	Depth interval
TUBING RECORD			Not perforated		
Size	Setting depth	Packer set at			

ACID, FRACTURE, SHOT, CEMENT SQUEEZE RECORD

Amount and kind of material used	Depth interval treated
None	

INITIAL PRODUCTION

Date of first production	Producing method (flowing, pumping, gas lift, etc.)				
None					
RATE OF PRODUCTION PER 24 HOURS	Oil	Gas	Water	Gas-oil ratio	CFPB
	bbls.	MCF	bbls.		
Disposition of gas (vented, used on lease or sold)				Producing interval(s)	

RECEIVED
 STATE CORPORATION COMMISSION
 JAN 25 1978
 CONSERVATION DIVISION
 WICHITA, KANSAS

INSTRUCTIONS: As provided in KCC Rule 82-2-125, within 90 days after completion of a well, one completed copy of this Drillers Log shall be transmitted to the State Geological Survey of Kansas, 4150 Monroe Street, Wichita, Kansas 67209. Copies of this form are available from the Conservation Division, State Corporation Commission, 3830 So. Meridian (P.O. Box 17027), Wichita, Kansas 66217. Phone AC 316-522-2206. If confidential custody is desired, please note Rule 82-2-125. Drillers Logs will be on an open file in the Oil and Gas Division, State Geological Survey of Kansas, Lawrence, Kansas. 66044.

15-167-21106-00-00

DESIGNATE TYPE OF COMP.: OIL, GAS, DRY HOLE, SWDW, ETC.:

Henson Mineral Group, Inc.

Well No. 1

Lease Name Godfred/Miller

Dry Hole

S 14 T 11SR 15W^EW

Plugged & Abandon

WELL LOG

Show all important zones of porosity and contents thereof; cored intervals, and all drill-stem tests, including depth interval tested, cushion used, time tool open, flowing and shut-in pressures, and recoveries.

SHOW GEOLOGICAL MARKERS, LOGS RUN, OR OTHER DESCRIPTIVE INFORMATION.

FORMATION DESCRIPTION, CONTENTS, ETC.	TOP	BOTTOM	NAME	DEPTH
red bed/sand	0	1038		
Anhydrite	1038	1080		
sandy shale/sand	1080	1260		
lime/sand/shale	1260	1900		
sand/shale	1900	2300		
shale	2300	2450		
sandy/shale	2450	2700		
sand/shale	2700	2900		

REC'D
STATE CORP
JAN 25 1978
WICHITA DIVISION
Wichita, Kansas

USE ADDITIONAL SHEETS, IF NECESSARY, TO COMPLETE WELL RECORD.

Date Received

Courtney E. Cook
Signature

Production Manager
Title

1/23/78
Date

Date