

STATE OF KANSAS
STATE CORPORATION COMMISSION


15-167-00669-00-00 Form CP-4

WELL PLUGGING RECORD

Give All Information Completely
Make Required Affidavit
Mail or Deliver Report to:
Conservation Division
State Corporation Commission
211 No. Broadway
Wichita, Kansas

Russell County, Sec. 18 Twp. 11 Rge. 15 (W)

Location as "NE/CNW/SW" or footage from lines SW SW SW
Lease Owner Morris G. Veverka Oil Company
Lease Name Chrysler Well No. 1
Office Address Plainville, Kansas
Character of Well (completed as Oil, Gas or Dry Hole) Dry Hole
Date well completed July 29 19 63
Application for plugging filed July 29 19 63
Application for plugging approved July 29 19 63
Plugging commenced July 29 19 63
Plugging completed July 29 19 63
Reason for abandonment of well or producing formation

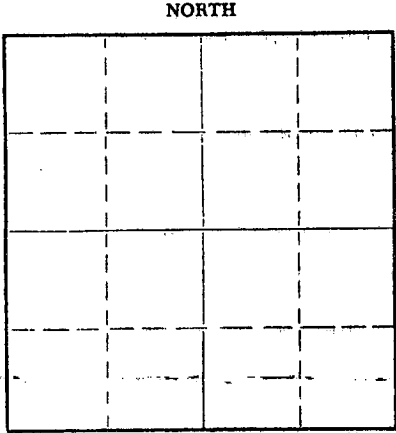

If a producing well is abandoned, date of last production 19
Was permission obtained from the Conservation Division or its agents before plugging was commenced? Yes

Name of Conservation Agent who supervised plugging of this well Don Truan
Producing formation Depth to top Bottom Total Depth of Well 3619 Feet
Show depth and thickness of all water, oil and gas formations.

OIL, GAS OR WATER RECORDS

CASING RECORD

FORMATION	CONTENT	FROM	TO	SIZE	PUT IN	PULLED OUT
		0	209	8 5/8	209	-0-

Describe in detail the manner in which the well was plugged, indicating where the mud fluid was placed and the method or methods used in introducing it into the hole. If cement or other plugs were used, state the character of same and depth placed, from feet to feet for each plug set.

Filled hole w/heavy mud to 200' - 1/2 Sk. hulls, plug & 25 Sks. cement.
Filled hole w/heavy mud to 40' 1/2 sack hulls, plug & 15 sacks cement.
Rat hole plugged w/5 sacks cement.

RECEIVED
STATE CORPORATION COMMISSION
AUG 5 1963
08-05-1963
CONSERVATION DIVISION
Wichita, Kansas


(If additional description is necessary, use BACK of this sheet)

Name of Plugging Contractor Leonard Reed
Address Great Bend, Kansas

STATE OF Kansas, COUNTY OF Russell, ss.
Joe K. Branum (employee of owner) or (owner or operator) of the above-described well, being first duly sworn on oath, says: That I have knowledge of the facts, statements, and matters herein contained and the log of the above-described well as filed and that the same are true and correct. So help me God.

(Signature) Joe K. Branum
Box 606, Russell, Kansas (Address)

1st. day of August, 19 63

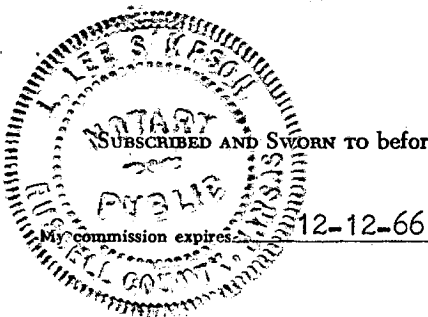

L. Lee Simpson Notary Public.

15-167-00669-00-00

W E L L L O G

OPERATOR: Morris G. Veverka Oil Co.
Plainville, Kansas

CONTRACTOR: Terrel Drilling & Producing
Russell, Kansas

LEASE: Chrysler #1

COMMENCED: July 20, 1963

LOCATION: SW SW SW, Sec. 18-11-15,
Russell County, Kansas


COMPLETED: July 29, 1963

DEPTHS & FORMATIONS

Clay & Shale	209	Lime & Shale	1680
Shale	365	Lime	1800
Sand Stks.	560	Shale & Lime	3151
Shale & Red Bed	1077	Lime	3235
Anhydrite	1117	Lime & Shale	3513
Shale & Shells	1175	Lime (R.T.D.)	3619


STATE OF KANSAS)
)
COUNTY OF RUSSELL) ss

Joe K. Branum, owner of Terrel Drilling and Producing, being first duly sworn on oath says: That I have knowledge of the facts, statements and matters herein contained and the log of the above described well as filed and that the same are true and correct.

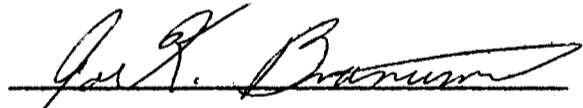

Joe K. Branum

Subscribed and sworn before me this 1st. day of August, 1963.

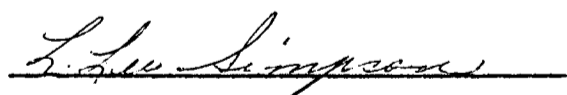

Notary Public Russell County

My Commission Expires: December 12, 1966

RECEIVED
STATE CORPORATION COMMISSION
AUG 5 1963
08-05-1963
CONSERVATION DIVISION
Wichita, Kansas