

15-167-03863-00-00

WELL PLUGGING RECORD

STATE OF KANSAS
STATE CORPORATION COMMISSION

Give All Information Completely
Make Required Affidavit
Mail or Deliver Report to:
Conservation Division
State Corporation Commission
800 Biting Building
Wichita, Kansas

OR

FORMATION PLUGGING RECORD

Strike out upper line
when reporting plug-
ging off formations.

RUSSELL County. Sec. 8 Twp 11 Rge. (E) 15 (W)

Location as "NE 1/4 NW 1/4 SW 1/4" or footage from lines. NE NE NE

Lease Owner. THOS. H. ALLAN, et al

Lease Name. MAIER Well No. 1

Office Address. 921 UNION NAT'L BANK BLDG., WICHITA 2, KANSAS

Character of Well (completed as Oil, Gas or Dry Hole). DRY HOLE

Date well completed. NOVEMBER 17 1950

Application for plugging filed. NOVEMBER 17 1950

Application for plugging approved. NOVEMBER 17 1950

Plugging commenced. NOVEMBER 18 1950


Plugging completed. NOVEMBER 18 1950

Reason for abandonment of well or producing formation. DRY

If a producing well is abandoned, date of last production. 19

Was permission obtained from the Conservation Division or its agents before plugging was commenced? YES

NORTH

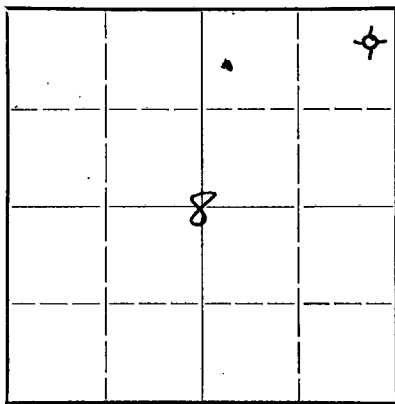

Locate well correctly on above
Section Plat

Name of Conservation Agent who supervised plugging of this well. Eldon Petty

Producing formation. ARBUCKLE Depth to top. 3422 Bottom. - - - - Total Depth of Well. 3459 Feet

Show depth and thickness of all water, oil and gas formations.

OIL, GAS OR WATER RECORDS

CASING RECORD

Table with 7 columns: Formation, Content, From, To, Size, Put In, Pulled Out. Row 1: Formation, Content, From, To, Size 8 5/8", Put In 97', Pulled Out NONE.

Describe in detail the manner in which the well was plugged, indicating where the mud fluid was placed and the method or methods used in introducing it into the hold. If cement or other plugs were used, state the character of same and depth placed, from feet to feet for each plug set.

97' to 92' Solid Rock Bridge
92' to Surface 30 Sacks of cement

RECEIVED
11-24-1950
NOV 24 1950

(If additional description is necessary, use BACK of this sheet)

Correspondence regarding this well should be addressed to THOS. H. ALLAN
Address 921 UNION NATIONAL BANK BLDG., WICHITA 2, KANSAS

STATE OF KANSAS, COUNTY OF SEDGWICK, ss.
THOS. H. ALLAN (employee of owner) or (owner or operator) of the above-described well,

being first duly sworn on oath, says: That I have knowledge of the facts, statements, and matters herein contained and the log of the above-described well as filed and that the same are true and correct. So help me God.

(Signature) Thos H. Allan

921 Union National Bank Bldg., Wichita 2, Kansas (Address)

SUBSCRIBED AND SWORN to before me this 22nd day of November, 1950.

Ocie M. Stewart Notary Public.



PLUGGING
FILE SEC 8 T 11 R 15 W
BOOK PAGE 44 LINE 17

15-167-03863-00-00

8 5/8" @ 97' - 50sx

Allan et al #1 Maier
NE NE NE 8-11-15W
Russell County, Kansas
Comm: 11/1/50 Compl: 11/17/50
Contractor: Tom Allan
Elevation: 1939 R B
I.P. D & A

Depth from Rotary Bushings

0 - 12 Soil
 22 Sand
 97 Blue Gumbo
 380 Gray speckled Shale with
 Lime Streaks
 460 Sand
 540 Shale
 600 Sand
 670 Shale
 690 Sand
 730 Shale
 770 Sand
 1050 Red Beds
 1100 Anhydrite
 1220 Red Beds
 1440 Red & Gray Shale
 1640 Shale & Salt
 1820 Lime & Shale
 1920 Shale
 1935 Lime
 2000 Shale & Shells
 2020 Red Shale
 2250 Shale & Shells
 2340 Lime & Shale
 2750 Shale & Shells
 2755 Sand
 2763 Shale
 2835 Lime with Shale Breaks
 2846 Shale
 2977 Lime with Shale Breaks
 2993 Shale
 3018 Lime & Shale
 3027 Shale
 3035 Lime
 3039 Black Shale
 3045 Lime
 3059 Shale
 3072 Lime, White Dense
 3086 Red & Gray Shale
 3210 Lime with Shale Breaks
 3223 Shale & Shells
 3358 Lime & Shale
 3422 Red, Green & Gray Shale
 with Lime Shells
 3459 T. D. Dolomite & Chert

FORMATIONS:

Top Anhydrite 1050
 Top Heebner 3035
 Top Dodge 3059
 Top Lansing 3086
 Top Arbuckle 3422

OIL SHOWS

3117-19 Brown Oolitic Lime Slightly Oil
 Stained, No Odor
 3297-99 White Crystalline Lime Slightly
 Oil Stained, No Odor
 3422-59 Weathered Crystalline Dolomite
 with Both Dead and Live Oil Stain,
 Faint Odor

TESTING

DST 3115-26 1 hr. 150' Muddy Salt Water
 DST 3296-3313 45 min 20' Mud & Trace Salt
 Water
 DST 3425-35 1 hr. 15' Mud

I certify that the Above is a true and correct copy of the well log on the above test.

Tom A. Allan

Subscribed and sworn to before me this 21st day of November, 1950

Ocie M. Stewart
Notary Public

My Commission expires June 14, 1954



11-24-1950

PLUGGING
 FILE SEC 8-T-4-R-120
 BOOK PAGE 46-11-17