

15-107-00340-00-00


WELL PLUGGING RECORD

Give All Information Completely  
Make Required Affidavit  
Mail or Deliver Report to:  
Conservation Division  
State Corporation Commission  
211 No. Broadway  
Wichita, Kansas

Russell County, Sec. 4 Twp. 11 Rge. 15 (E) W(W)

Location as "NE/CNW/SW" or footage from lines SE SE SW  
Lease Owner Shields Oil Producers  
Lease Name Worley "A" Well No. 2  
Office Address Shields Building, Russell, Kansas  
Character of Well (completed as Oil, Gas or Dry Hole) Dry Hole  
Date well completed November 29 1958  
Application for plugging filed November 29 1958  
Application for plugging approved November 29 1958  
Plugging commenced November 29 1958  
Plugging completed November 29 1958  
Reason for abandonment of well or producing formation Dry Hole

NORTH

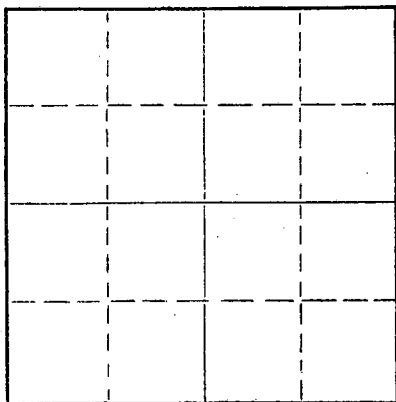

Locate well correctly on above Section Plat

If a producing well is abandoned, date of last production 19  
Was permission obtained from the Conservation Division or its agents before plugging was commenced? Yes

Name of Conservation Agent who supervised plugging of this well Donald Truan  
Producing formation \_\_\_\_\_ Depth to top \_\_\_\_\_ Bottom \_\_\_\_\_ Total Depth of Well 3440 Feet  
Show depth and thickness of all water, oil and gas formations.

OIL, GAS OR WATER RECORDS

CASING RECORD

FORMATION	CONTENT	FROM	TO	SIZE	PUT IN	PULLED OUT
				8 5/8"	318'	Cmtd. w/165 sax

Describe in detail the manner in which the well was plugged, indicating where the mud fluid was placed and the method or methods used in introducing it into the hole. If cement or other plugs were used, state the character of same and depth placed, from \_\_\_\_\_ feet to \_\_\_\_\_ feet for each plug set.

Fill w/heavy mud to 310'  
Set bridging plug @ 310' w/1/4 sax hulls on plug  
Dump 25 sax cement on plug thru drill pipe  
Fill w/heavy mud to 40'  
Set bridging plug @ 40' w/1/4 sax hulls on plug  
Dump 10 sax cement on plug to cellar

(If additional description is necessary, use BACK of this sheet)

Name of Plugging Contractor Shields Drilling Company, Inc.  
Address Shields Bldg., Russell, Kansas

STATE OF Kansas, COUNTY OF Russell, ss.  
R. J. Shields (employee of owner) or (owner or operator) of the above-described well, being first duly sworn on oath, says: That I have knowledge of the facts, statements, and matters herein contained and the log of the above-described well as filed and that the same are true and correct. So help me God

(Signature) RJ Shields  
Shields Building, Russell, Kansas (Address)

SUBSCRIBED AND SWORN TO before me this 2nd day of December, 1958

My commission expires March 6, 1961

RECEIVED  
STATE CORPORATION COMMISSION

DEC 3 - 1958  
12-03-1958  
CONSERVATION DIVISION  
Wichita, Kansas

Notary Public  
Harriet V. Peterson  
PLUGGING  
FILE SEC. 4 T. 11. R. 15W  
BOOK PAGE 1 LINE 16




*Shields*  
15-167-00340-00-00  
WELL LOG

*Russell, Kansas*

Operator: Shields Oil Producers  
Well: Worley "A" #2  
Commenced: November 17, 1958  
Completed: November 29, 1958  
Contractor: Shields Drilling Co., Inc.

Well Description: SE SE SW  
Sec. 4-11S-15W  
Russell County, Kansas

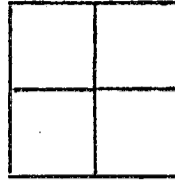

CASING RECORD

Size	Run	Pulled
8 5/8"	318'	Cmtd. w/165 sax

Elevation: 1927' RB  
Treatment:

Production: D & A

Tops:	Heebner	3010'
	Toronto	3031'
	Lansing-KC	3068'
	Shale Congl.	3384'
	Congl. Sand.	3395'
	Ch. Congl.	3410'

..... Figures Indicate Bottom of Formations .....

Shale; Clay	318'
Shale & Shells	330'
Shale; Shells & Sand	800'
Shale; Shells & Red Bed	1021'
Anhydrite	1058'
Shale & Shells	1720'
Shale & Lime	1825'
Broken Lime	1960'
Shale & Lime	2040'
Broken Lime	2290'
Shale & Lime	2310'
Shale & Lime Shells	2455'
Shale & Shells	2630'
Lime & Shale	3100'
Lime	3215'
Lime & Shale	3400'
Conglomerate	3440' RTD

**RECEIVED**  
STATE CORPORATION COMMISSION

<b>PLUGGING</b>	
FILE	SEC. 4 T. 11 R. 15W
BOOK	PAGE 1 LINE 16

DEC 3 - 1958  
12-03-1958  
Notes  
CONSERVATION DIVISION  
Wichita, Kansas

DST #1 3383' - 3400' Tool open w/weak blow for 36 min.  
Rec. 5 min. BHP - 110#/20 min.