


15-065-00899-0000

STATE OF KANSAS
STATE CORPORATION COMMISSION

WELL PLUGGING RECORD

Give All Information Completely
Make Required Affidavit
Mail or Deliver Report to:
Conservation Division
State Corporation Commission
800 Bitting Building
Wichita, Kansas

Graham County. Sec. 24 Twp. 9S Rge. 23 000 (W)
Location as "NE/CNW/SE/SW" or footage from lines NW NW NE
Lease Owner PETROLEUM MANAGEMENT, INC.
Lease Name NINEMIRE "B" Well No. 1
Office Address Central Building, Wichita 2, Kansas
Character of Well (completed as Oil, Gas or Dry Hole) Dry Hole
Date well completed January 23, 19 56
Application for plugging filed January 27, 19 56
Application for plugging approved January 30 19 56
Plugging commenced February 8 19 56
Plugging completed February 11 19 56
Reason for abandonment of well or producing formation Non Commercial
If a producing well is abandoned, date of last production 19
Was permission obtained from the Conservation Division or its agents before plugging was commenced? Yes

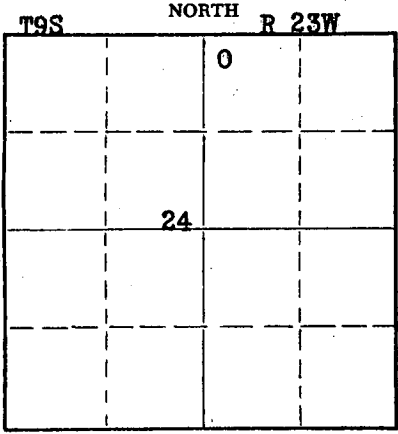

Locate well correctly on above Section Plat

Name of Conservation Agent who supervised plugging of this well Eldon Petty
Producing formation _____ Depth to top _____ Bottom _____ Total Depth of Well 4168 Feet
Show depth and thickness of all water, oil and gas formations.

OIL, GAS OR WATER RECORDS

CASING RECORD

FORMATION	CONTENT	FROM	TO	SIZE	PUT IN	PULLED OUT
Heebner		3644		8-5/8"	157'	None
Toronto		3664		5-1/2"	3892'	3242'
Lansing		3679				
Base Kansas City		3899		Casing perforated from		
Conglomerate		4107		3834' to	3838'	
Arbuckle		4168				

Describe in detail the manner in which the well was plugged, indicating where the mud fluid was placed and the method or methods used in introducing it into the hole. If cement or other plugs were used, state the character of same and depth placed, from _____ feet to _____ feet for each plug set.

Filled the hole with sand from 4168' to 3830' and ran 5 sacks of cement.
Mudded the hole to 157', set a 10' rock bridge and ran 10 sacks of cement.
Mudded the hole to 30', set a 10' rock bridge and ran 10 sacks of cement on top. Plugging completed.

Handwritten initials: 28 26 29 155

(If additional description is necessary, use BACK of this sheet)

Name of Plugging Contractor West Supply Company, Inc.
Address Chase, Kansas

STATE OF Kansas, COUNTY OF Sedgwick, ss.
John W. Ritchey (employee of owner) or (owner or operator) of the above-described well, being first duly sworn on oath, says: That I have knowledge of the facts, statements, and matters herein contained and the log of the above-described well as filed and that the same are true and correct. So help me God.

(Signature) John W. Ritchey
Central Building, Wichita 2, Kansas (Address)

SUBSCRIBED AND SWORN TO before me this 21st day of February, 19 56

My commission expires April 23, 1958

Mare C. Murphy
Notary Public.
RECEIVED
STATE CORPORATION COMMISSION
2-23-56
FEB 23 1956
CONSERVATION DIVISION
Wichita, Kansas

PLUGGING
FILE SEC 24 T 9 R 23W
BOOK PAGE 34 LINE 29

CTA
 5/24/56
 15-065-00899-0000

TRANSIT CORPORATION
DRILLER'S LOG

NW NW NE Sec. 24-08-23W..
Graham County, Kansas

Ninewire "B" #1

Elevation 2384-KB
 Commenced 1-4-56
 Completed 1-15-56

<u>Formation</u>	<u>From</u>	<u>To</u>	
Surface & Shale	0	50	
Shale & Sand	50	120	
Shells	120	157	
Shale & Shells	157	980	
Shale & Sand	980	1170	
Sand	1170	1330	
Shale	1330	1475	
Sand	1475	1695	
Shale & Sand	1695	1710	
Shale, sand, red bed	1710	1800	
Shale & red bed	1800	1952	
Anhydrite	1952	1997	
Shale	1997	2465	
Shale & red bed	2465	2525	
Shale & Lime	2525	2990	
Lime & Shale	2990	3672	
Lime	3672	3869	
Lime & Shale	3869	3990	
Lime & Shale Streaks	3990	4021	
Lime & Shale	4021	4120	
Lime & Chert	4120	4168	TD(5 1/2" casing cemented at 3892' w/ 125 sk. cement)

6-5/8"
 Set 157' casing w/
 150 sk. cement

Formation Tops

Hoebner	3642 (-1258)
Toronto	3682 (-1278)
Lensing-K.C.	3676 (-1292)
Base K. C.	3897 (-1513)
Basal Pennsylv.	
Conspuerate	4105 (-1721)
Arbuckle	4159 (-1775)

I hereby certify the foregoing to be a true and accurate Driller's Log of the formations encountered in the above well.

TRANSIT CORPORATION
 BY C. W. Dodson
 Office Manager

Subscribed and sworn to before me this 25th day of January, 1956.

 Notary Public

My commission expires 1-20-59.

PLUGGING
 FILE SEC 24 T 9 R 23 W
 BOOK PAGE 34 LINE 39