


WELL PLUGGING RECORD

Give All Information Completely  
Make Required Affidavit  
Mail or Deliver Report to:  
Conservation Division  
State Corporation Commission  
211 No. Broadway  
Wichita, Kansas

Graham County, Sec. 24 Twp. 9S Rge. (E) 23(W)

Location as "NE/CNW%SW%" or footage from lines C - NW - SE  
Lease Owner Rock Island Oil & Refining Company, Inc.  
Lease Name Ninemire Well No. 3  
Office Address 321 West Douglas, Wichita, Kansas  
Character of Well (completed as Oil, Gas or Dry Hole) Dry Hole  
Date well completed December 8 19 64  
Application for plugging filed December 8 19 64  
Application for plugging approved December 8 19 64  
Plugging commenced December 8 19 64  
Plugging completed December 8 19 64  
Reason for abandonment of well or producing formation No producible shows

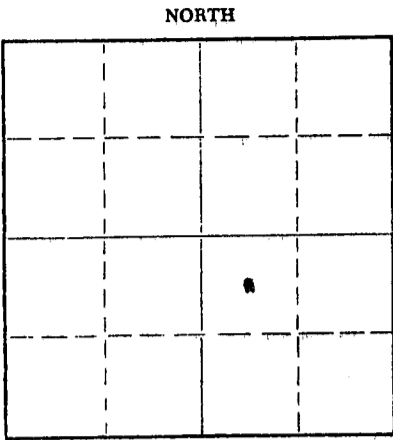

Locate well correctly on above  
Section Plat

If a producing well is abandoned, date of last production 19  
Was permission obtained from the Conservation Division or its agents before plugging was commenced? Yes

Name of Conservation Agent who supervised plugging of this well W. L. Nichols Moreland, Kansas  
Producing formation Depth to top Bottom Total Depth of Well Feet  
Show depth and thickness of all water, oil and gas formations.

OIL, GAS OR WATER RECORDS

CASING RECORD

FORMATION	CONTENT	FROM	TO	SIZE	PUT IN	PULLED OUT
				8 5/8"	218'	

Describe in detail the manner in which the well was plugged, indicating where the mud fluid was placed and the method or methods used in introducing it into the hole. If cement or other plugs were used, state the character of same and depth placed, from feet to feet for each plug set.

Added heavy mud to 600' through drill pipe, placed wooden plug and 20 sacks of cement. Added heavy mud to 180', placed wooden plug, 1/2 sack hulls and 20 sacks of cement. Added heavy mud to 35', placed wooden plug, 1/2 sack hulls and 10 sacks of cement to base of cellar. Plugged rat hole with 2 sacks of cement.

RECEIVED  
STATE CORPORATION COMMISSION  
1-4-65  
JAN 4 1965

CONSERVATION DIVISION  
Wichita, Kansas

(If additional description is necessary, use BACK of this sheet)

Name of Plugging Contractor Garvey Drilling Company  
Address RR #2 Great Bend, Kansas

STATE OF Kansas, COUNTY OF Barton, ss.  
Sam N. Stephens (employee of owner) or (owner or operator) of the above-described well, being first duly sworn on oath, says: That I have knowledge of the facts, statements, and matters herein contained and the log of the above-described well as filed and that the same are true and correct. So help me God.

(Signature) Sam N. Stephens  
Garvey Drilling Co. RR #2 Great Bend, Kansas (Address)

SUBSCRIBED AND SWORN to before me this 30th day of December, 19 64

Notary Public.

My commission expires October 19th, 1968

# WELL LOG 15-005-19186-0000


COMPANY Rock Island Oil and Refining Company, Inc. SEC. 24 T. 9S R. 23W  
FARM Ninemire NO. 3 LOC. C NW SE

TOTAL DEPTH 3965' COUNTY Graham

COMM. 11-30-64 COMP. 12-8-64

CONTRACTOR Garvey Drilling Company

CASING 8 5/8" @ 218' w/175 sx

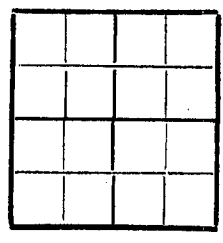

ELEVATION 2438 KB

PRODUCTION D & A

FIGURES INDICATE BOTTOM OF FORMATIONS

- 40' Surface Clay
- 1300' Shale
- 1540' Shale, Shells and Pyrite
- 1580' Shale and Shells
- 1750' Sand
- 2020' Shale
- 2052' Anhydrite
- 2470' Shale
- 2705' Shale and Shells
- 2835' Lime and Shale
- 3040' Lime
- 3653' Lime and Shale
- 3965' Lime
- 3965' RTD

**RECEIVED**  
STATE CORPORATION COMMISSION

JAN 4 1965

CONSERVATION DIVISION  
Wichita, Kansas

State of Kansas }  
County of Barton } SS

I, Sam N. Stephens of Garvey Drilling Company

upon oath state the above and foregoing is a true and correct copy of the log of the Ninemire #3 well.

*Sam N. Stephens*

Subscribed and sworn to before me this 30th day of December 19 64

My Commission Expires: October 19th, 1968

*Lawrence J. Hoffman*  
NOTARY PUBLIC

