

WELL PLUGGING RECORD

Give All Information Completely
Make Required Affidavit
Mail or Deliver Report to:
Conservation Division
State Corporation Commission
211 No. Broadway
Wichita, Kansas

GRAHAM

County. Sec. 25 Twp. 9 Rge. 23 (X) W (W)

Location as "NE/CNW/SW" or footage from lines SW NW SE

Lease Owner DANE G HANSEN TRUST

Lease Name LA CERTE "A" Well No. 5

Office Address LOGAN, KANSAS

Character of Well (completed as Oil, Gas or Dry Hole) DRY HOLE

Date well completed 5/30/66 19

Application for plugging filed 5/30/66 19

Application for plugging approved 5/30/66 19


Plugging commenced 5/30/66 19

Plugging completed 5/30/66 19

Reason for abandonment of well or producing formation TOO LOW STRUCTURALLY

If a producing well is abandoned, date of last production 19

Was permission obtained from the Conservation Division or its agents before plugging was commenced? YES

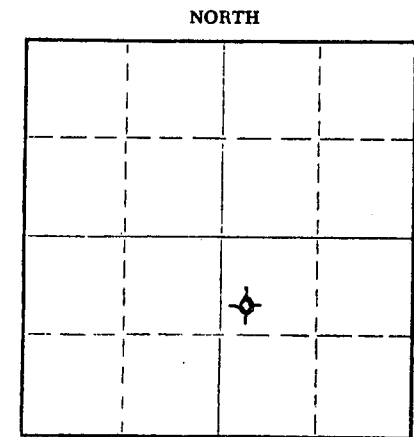

Locate well correctly on above Section Plat

Name of Conservation Agent who supervised plugging of this well W. L. NICHOLS, MORELAND, KANSAS

Producing formation _____ Depth to top _____ Bottom _____ Total Depth of Well 3904 Feet

Show depth and thickness of all water, oil and gas formations.

OIL, GAS OR WATER RECORDS

CASING RECORD

FORMATION	CONTENT	FROM	TO	SIZE	PUT IN	PULLED OUT
				8-5/8"	192.83'	None

Describe in detail the manner in which the well was plugged, indicating where the mud fluid was placed and the method or methods used in introducing it into the hole. If cement or other plugs were used, state the character of same and depth placed, from _____ feet to _____ feet for each plug set.

FILLED WITH HEAVY MUD TO 540'. SET PLUG. PUT IN 25 SACKS CEMENT. FILLED WITH HEAVY MUD TO 190'. SET PLUG. PUT IN 1/2 SACK HULLS AND 20 SACKS CEMENT. FILLED WITH HEAVY MUD UP TO 40'. SET PLUG. FILLED TO TOP WITH 1/2 SACK HULLS AND 10 SACKS CEMENT.

RECEIVED
STATE CORPORATION COMMISSION
JUN 13 1966
CONSERVATION DIV.

Name of Plugging Contractor C-G DRILLING COMPANY
Address 107 RULE BUILDING, WICHITA 2, KANSAS


STATE OF KANSAS, COUNTY OF SEDGWICK, ss.
JAY H. GALLOWAY

well, being first duly sworn on oath, says: That I have knowledge of the facts, statements, and matters herein contained and the log of the above-described well as filed and that the same are true and correct. So help me God.

(Signature) Jay H Galloway
JAY H. GALLOWAY
107 RULE BUILDING (Address)

Subscribed and sworn to before me this 3 day of JUNE, 1966

My commission expires 5/20/67
VICKY JACOBS Notary Public.

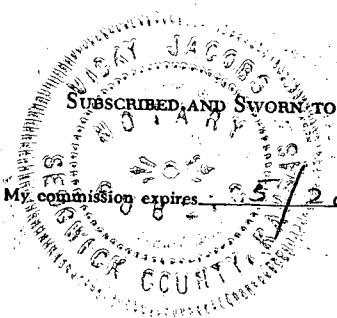

WELL LOG

OPERATOR: DANE G HANSEN TRUST
 WELL NAME: LA CERTE "A" # 5 LOCATION: SW NW SE 25-9-23
 COUNTY: GRAHAM STATE: KANSAS
 WELL COMMENCED: 5/23/66 WELL COMPLETED: 5/30/66
 ELEVATION: 2408 KB TOTAL DEPTH: 3904'
 PRODUCTION: DRY & ABANDONED RIG NO: #1
 CASING - 8-5/8": 10 joints, 192.83' W/140 sacks cement + 2 sx ca. cl.
 5-1/2": _____

All Measurements taken from the top of rotary bushing.

FROM	TO	FORMATION	DEVIATION FROM VERTICAL	REMARKS:
0	192	SAND	1/4°	500'
192	1530	SAND & SHALE	1/2°	1000'
1530	1745	SAND	3/4°	1500'
1745	1990	RED BED & SHALE	2°	2000'
1990	2032	ANHYDRITE	1-3/4°	2114'
2032	2100	SHALE	1-3/4°	2235'
2100	2440	SHALE & SHALE	1-1/2°	2345'
2440	3640	LIME & SHALE	1-1/4°	2475'
3640	3904	LIME	1°	2620'
			1°	2810'
			1-1/2°	3300'
			1-1/4°	3510'
				DST #1 3828-3864
				DST #2 3865-3904

RECEIVED
 STATE CORPORATION COMMISSION

JUN 12 1966

STATE OF KANSAS)
 COUNTY OF SEDGWICK) SS:

The undersigned hereby certifies that to the best of his knowledge and belief, the above facts are true and correct.

C-G DRILLING CO.

By Jay H. Galloway
 JAY H. GALLOWAY



SUBSCRIBED AND SWORN TO, BEFORE ME, THIS 3 day of JUNE, 1966

My comm. exp: May 20, 1967

Vicky Jacobs
 Vicky Jacobs - Notary Public