

15-065-03116-0000

STATE OF KANSAS
STATE CORPORATION COMMISSION

Form CP-4


Give All Information Completely
Make Required Affidavit
Mail or Deliver Report to:
Conservation Division
State Corporation Commission
211 No. Broadway
Wichita, Kansas

WELL PLUGGING RECORD

GRAHAM County, Sec. 25 Twp. 9 Rge. 23W (E) (W)

Location as "NE/CNW/SW" or footage from lines. C 8/2 SW SW
Lease Owner WOODMAN & IANNITTI OIL COMPANY
Lease Name LA CERETE Well No. 1
Office Address 706 UNION NATIONAL BLDG.-WICHITA, KANSAS
Character of Well (completed as Oil, Gas or Dry Hole) OIL
Date well completed _____ 19____
Application for plugging filed SEPTEMBER 16 19 65
Application for plugging approved _____ 19____
Plugging commenced SEPTEMBER 17 19 65
Plugging completed SEPTEMBER 22 19 65
Reason for abandonment of well or producing formation DEPLETED

NORTH

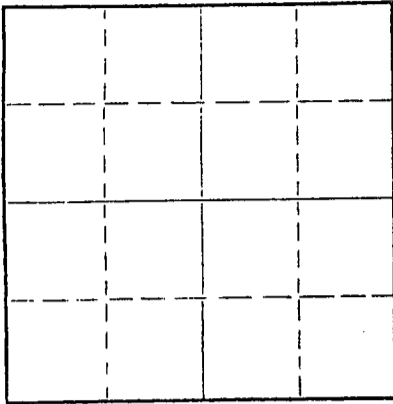

Locate well correctly on above
Section Plat

If a producing well is abandoned, date of last production _____ 19____
Was permission obtained from the Conservation Division or its agents before plugging was commenced? YES

Name of Conservation Agent who supervised plugging of this well W. L. NICHOLS
Producing formation _____ Depth to top _____ Bottom _____ Total Depth of Well 3924' Feet
Show depth and thickness of all water, oil and gas formations.

OIL, GAS OR WATER RECORDS

CASING RECORD

FORMATION	CONTENT	FROM	TO	SIZE	PUT IN	PULLED OUT
				8 5/8"	181'	NONE
				5 1/2"	3924'	1022.74'

Describe in detail the manner in which the well was plugged, indicating where the mud fluid was placed and the method or methods used in introducing it into the hole. If cement or other plugs were used, state the character of same and depth placed, from _____ feet to _____ feet for each plug set.

3905 - 3685' - SAND
3685' - 3645' - 5 SACKS CEMENT
3645' - 400' - MUD
400' - 385' - ROCK BRIDGE
385' - BASE - 5 1/2 YARDS READY MIXED CONCRETE.

RECEIVED
STATE CORPORATION COMMISSION

OCT 25 1965

CONSERVATION DIVISION
Wichita, Kansas

(If additional description is necessary, use BACK of this sheet)

Name of Plugging Contractor SANTA-FE PIPE & SUPPLY, INC.
Address P. O. BOX 562 - GREAT BEND, KANSAS

STATE OF KANSAS, COUNTY OF BARTON, ss.
T. L. NUTT (employee of owner) of the above-described well, being first duly sworn on oath, says: That I have knowledge of the facts, statements, and matters herein contained and the log of the above-described well as filed and that the same are true and correct. So help me God.

(Signature) *T. L. Nutt*
P. O. BOX 562 - GREAT BEND, KANSAS
(Address)

SUBSCRIBED AND SWORN to before me this 22nd day of October, 19 65



Mary M. Guesnier
Mary M. Guesnier Notary Public.

15-065-03116-0000

KANSAS GEOLOGICAL SOCIETY
KANSAS WELL LOG BUREAU - KANSAS WELL SAMPLE BUREAU
KANSAS GEOLOGICAL SOCIETY BUILDING
508 EAST MURDOCK - WICHITA, KANSAS

COMPANY Woodman & Iannitti Drilling Co.

SEC. 25 T. 9 R. 23W

FARM Lacerte NO. 1


LOC. C S/2 SW SW

TOTAL DEPTH 3925'
COMM. Oct. 29, 58 COMP. Nov. 6, 58

COUNTY Graham

SHOT OR TREATED
CONTRACTOR Woodman & Iannitti Drilling Co.

KANSAS

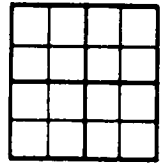

CASING

20 - 10
15 8 5/8 @ 181' w/125 sx
12 6
13 5 1/2 @ 3924' w/25 sx and 23 gal. latex

ELEVATION 2404 KB

PRODUCTION

FIGURES INDICATE BOTTOM OF FORMATIONS

100 Sand Clay
140 Clay
181 Blue Shale
750 Shale
1547 Shale & Redbed
1735 Sand
1795 Shale & Redbed
1975 Shale & Redbed
2010 Anhydrite
2055 Shale
2290 Shale
2500 Shale & Lime
2670 Shale & Lime
2785 Lime
2905 Lime
3070 Lime
3140 Lime
3240 Lime
3345 Lime & Shale
3430 Lime
3490 Lime
3570 Lime
3658 Lime
3700 Lime
3755 Lime
3810 Lime
3865 Lime
3882 Lime
3920 Lime
3925 Total Depth

RECEIVED
STATE CORPORATION COMMISSION
OCT 14 1965

CONSERVATION DIVISION
WICHITA, KANSAS

I certify the above to be a true and correct copy of the driller's log to the best of my knowledge and belief.

WOODMAN & IANNITTI DRILLING CO.

By K. T. Woodman
K. T. Woodman