

Give All Information Completely
Make Required Affidavit
Mail or Deliver Report to:
Conservation Division
State Corporation Commission
211 No. Broadway
Wichita, Kansas

WELL PLUGGING RECORD

Graham County, Sec. 26 Twp. 9 Rge. 23 (E) W (W)

Location as "NE/CNW%SW%" or footage from lines C S 1/2 SE 1/4 NW 1/4

Lease Owner D. G. Hansen

Lease Name Kansas State University "B" Well No. 1

Office Address Logan, Kansas

Character of Well (completed as Oil, Gas or Dry Hole) dry hole

Date well completed Sept. 8 19 62

Application for plugging filed Sept. 8 19 62

Application for plugging approved Sept. 8 19 62


Plugging commenced Sept. 8 19 62

Plugging completed Sept. 8 19 62

Reason for abandonment of well or producing formation Too low structurally

If a producing well is abandoned, date of last production 19

Was permission obtained from the Conservation Division or its agents before plugging was commenced? Yes

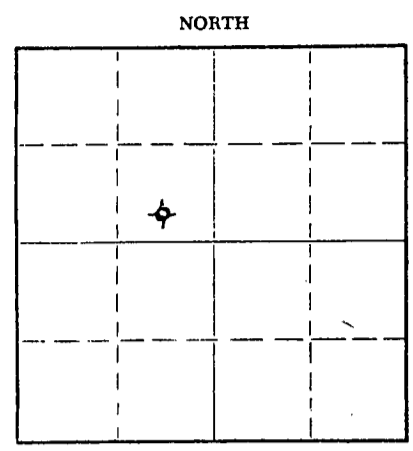

Locate well correctly on above Section Plat

Name of Conservation Agent who supervised plugging of this well Eldon Petty

Producing formation Depth to top Bottom Total Depth of Well Feet

Show depth and thickness of all water, oil and gas formations.

OIL, GAS OR WATER RECORDS

CASING RECORD

FORMATION	CONTENT	FROM	TO	SIZE	PUT IN	PULLED OUT
				8-5/8"	191.51'	none

Describe in detail the manner in which the well was plugged, indicating where the mud fluid was placed and the method or methods used in introducing it into the hole. If cement or other plugs were used, state the character of same and depth placed, from feet to feet for each plug set.

Filled hole with heavy mud to 550'. Set plug. Put in 20 sacks cement; filled hole with heavy mud to 185'. Set plug. Put in 1/2 sack hulls, 20 sacks cement. Filled hole with heavy mud to 35'. Filled hole to top with 1/2 sack hulls and 20 sacks cement.

RECEIVED
STATE CORPORATION COMMISSION
9-19-62
SEP 19 1962
CONSERVATION DIVISION
Wichita, Kansas

(If additional description is necessary, use BACK of this sheet)

Name of Plugging Contractor C-G Drilling Co.
Address 107 Rule Building, Wichita, Kansas

STATE OF Kansas, COUNTY OF Sedgwick, ss. G. F. Galloway


(employee of owner) or (owner) of the above-described well, being first duly sworn on oath, says: That I have knowledge of the facts, statements, and matters herein contained and the log of the above-described well as filed and that the same are true and correct. So help me God. C-G Drilling Co.

(Signature) G. F. Galloway
107 Rule Bldg., Wichita, Kansas
(Address)

SUBSCRIBED AND SWORN to before me this 10 day of September, 19 62

My commission expires May 20, 1963

Vicky Jacobs
Notary Public.

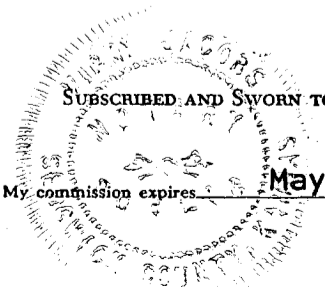

W E L L L O G

OPERATOR D. G. Hansen SEC. 26-9-23W
 WELL NAME Kansas State University "B" LOC. C S $\frac{1}{2}$ SE $\frac{1}{4}$ NW $\frac{1}{4}$
 TOTAL DEPTH 3950' COUNTY Graham
 COMM. August 29, 1962 COMP. September 8, 1962 STATE Kansas
 RIG NO. 1 ELEVATION 2421' RB
 CASING: Set 191.51' (10 jts.) 8-5/8" OD PRODUCTION: D & A
 Surface Casing.

All measurements taken from the top of rotary bushing.

FROM	TO	FORMATION	DEVIATION FROM VERTICAL	REMARKS:
0	129	Sand		
129	170	Shale		
170	191	Shale		
191	650	Shale-Sand	500° - 0	
650	1225	Shale-Sand		
1225	1270	Shale		
1270	1380	Sand		
1380	1560	Shale		
1560	1780	Sand		
1780	1910	Shale		
1910	2013	Red Bed		
2013	2051	Anhydrite	2020 - $\frac{1}{20}^{\circ}$	
2051	2105	Shell-Shale	2590 - $\frac{1}{2}^{\circ}$	
2105	2825	Shale-Lime		
2825	2950	Lime-Shale		
2950	3090	Shale-Lime		
3090	3270	Lime-Shale	3128 - $\frac{1}{4}^{\circ}$	
3270	3460	Shale-Lime		
3460	3570	Lime-Shale		
3570	3640	Shale-Lime		
3640	3790	Lime-Shale		
3790	3945	Lime		DST 3865-3882'
3945	3950	Lime-Shale	3950 - 0	DST 3880-3902'

RECEIVED
 STATE COMMISSION

SEP 10 1962

CONSERVATION DIVISION
 Wichita, Kansas

STATE OF KANSAS)
)
 COUNTY OF SEDGWICK) SS.

The undersigned hereby certifies that to the best of his knowledge and belief, the above facts are true and correct.

C-G DRILLING CO.
 By G. F. Galloway
 G. F. Galloway
 THIS 11 day of September 1962.
Vicky Jacobs
 Vicky Jacobs, Notary Public

