


Give All Information Completely  
Make Required Affidavit  
Mail or Deliver Report to:  
Conservation Division  
State Corporation Commission  
211 No. Broadway  
Wichita, Kansas

WELL PLUGGING RECORD

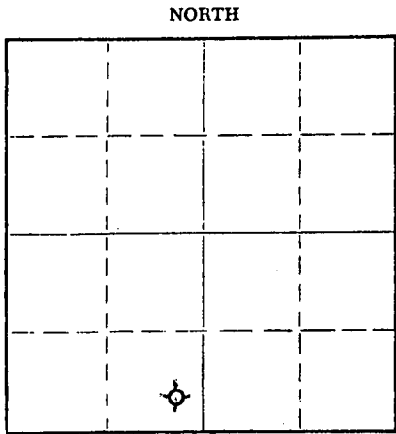

Locate well correctly on above  
Section Plat

Graham County. Sec. 26 Twp. 9S Rge. 23 (E) W (W)  
Location as "NE/CNW/SW" or footage from lines SE SE SW  
Lease Owner D. G. Hansen  
Lease Name Sparks Well No. 3  
Office Address Logan, Kansas  
Character of Well (completed as Oil, Gas or Dry Hole) Dry hole  
Date well completed Feb. 17 19 63  
Application for plugging filed Feb. 17 19 63  
Application for plugging approved Feb. 17 19 63  
Plugging commenced Feb. 17 19 63  
Plugging completed Feb. 17 19 63  
Reason for abandonment of well or producing formation Too low structurally  
If a producing well is abandoned, date of last production \_\_\_\_\_ 19 \_\_\_\_  
Was permission obtained from the Conservation Division or its agents before plugging was commenced? Yes  
Name of Conservation Agent who supervised plugging of this well W. L. Nichols  
Producing formation \_\_\_\_\_ Depth to top \_\_\_\_\_ Bottom \_\_\_\_\_ Total Depth of Well \_\_\_\_\_ Feet  
Show depth and thickness of all water, oil and gas formations.

OIL, GAS OR WATER RECORDS				CASING RECORD		
FORMATION	CONTENT	FROM	TO	SIZE	PUT IN	PULLED OUT
				8-5/8"	196'	none

Describe in detail the manner in which the well was plugged, indicating where the mud fluid was placed and the method or methods used in introducing it into the hole. If cement or other plugs were used, state the character of same and depth placed, from \_\_\_\_\_ feet to \_\_\_\_\_ feet for each plug set.


Filled hole with heavy mud to 540'. Set plug. Put in 20 sacks cement. Filled with heavy mud to 190'. Set plug. Put in 1/2 sack hulls & 20 sacks cement. Filled with heavy mud to 40'. Filled to top with 1/2 sack hulls and 10 sacks cement.

STATE OF KANSAS  
2-25-63  
FEB 25 1963  
CONSERVATION DIVISION  
WICHITA, KANSAS

(If additional description is necessary, use BACK of this sheet)  
Name of Plugging Contractor C-G Drilling Co.  
Address 107 Rule Building, Wichita 2, Kansas

STATE OF Kansas, COUNTY OF Sedgwick, ss.  
Jay H. Galloway (employee of owner) or (owner or operator) of the above-described well, being first duly sworn on oath, says: That I have knowledge of the facts, statements, and matters herein contained and the log of the above-described well as filed and that the same are true and correct. So help me God.

(Signature) Jay H. Galloway  
107 Rule Building, Wichita, Kansas (Address)  
SUBSCRIBED AND SWORN to before me this 17th day of February, 19 63  
Vicky Jacobs Notary Public.  
My commission expires May 20, 1963

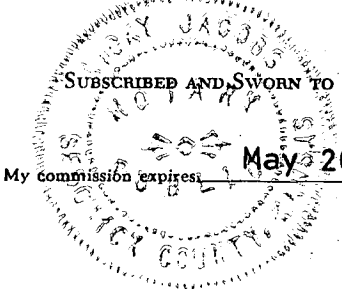

WELL LOG

OPERATOR	D. G. HANSEN	SEC.	26-9S-23W
WELL NAME	SPARKS #3	LOC.	SE SE SW
TOTAL DEPTH	3915	COUNTY	GRAHAM
COMM.	2/8/63	COMP.	2/17/63
RIG NO.	1	STATE	Kansas
CASING:	196' of 8-5/8" OD Surface	ELEVATION	2398' K.B.
		PRODUCTION:	D & A

All measurements taken from the top of rotary bushing.

FROM	TO	FORMATION	DEVIATION FROM VERTICAL	REMARKS:
0	170	Sand		
170	196	Shale		
196	880	Shale-Sand	500' - 1/2°	
880	1500	Shale	1000' - 1/2	
1500	1740	Sand-Shale	1500' - 1/2	
1740	1975	Red Bed		
1975	2010	Anhydrite	2000' - 1/2	
2010	2380	Shale-Shells		
2380	2710	Shale-Lime	2500' - 1/4	
2710	3345	Lime-Shale	2950' - 1/4	
3345	3915	Lime	3500' - 1/2	#1DST - 3760'-3774' #2DST - 3833'-3850' #3DST - 3845'-3868'

RECEIVED  
STATE CORPORATION COMMISSION

FEB 25 1963

CONSERVATION DIVISION  
Wichita, Kansas

STATE OF KANSAS )  
COUNTY OF SEDGWICK ) SS.

The undersigned hereby certifies that to the best of his knowledge and belief, the above facts are true and correct.

C-G DRILLING CO.

By Jay H. Galloway  
Jay H. Galloway

THIS 17 day of February, 1963.

Vicky Jacobs  
Vicky Jacobs - Notary Public

SUBSCRIBED AND SWORN TO, BEFORE ME,  
My commission expires:  
May 20, 1963  
NOTARY PUBLIC  
SEDGWICK COUNTY, KANSAS