

WELL PLUGGING RECORD

Give All Information Completely
Make Required Affidavit
Mail or Deliver Report to:
Conservation Division
State Corporation Commission
211 No. Broadway
Wichita, Kansas

Graham County, Sec. 26 Twp. 9 Rge. 23 (E) W (W)

Location as "NE/CNW/SW" or footage from lines C SW/4

Lease Owner D. G. Hansen

Lease Name Sparks Well No. 5

Office Address Logan, Kansas

Character of Well (completed as Oil, Gas or Dry Hole) Dry Hole

Date well completed August 15, 1963 1963

Application for plugging filed August 15, 1963 1963

Application for plugging approved August 15, 1963 1963


Plugging commenced August 15, 1963

Plugging completed August 15, 1963

Reason for abandonment of well or producing formation Too low Structurally

If a producing well is abandoned, date of last production _____ 19____

Was permission obtained from the Conservation Division or its agents before plugging was commenced? Yes

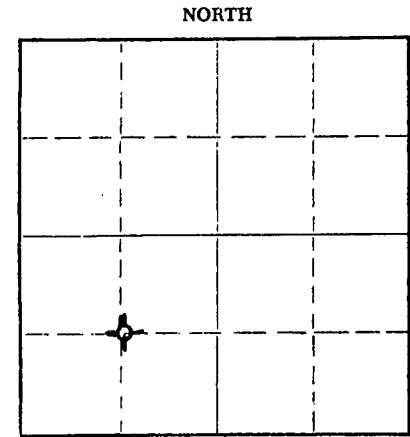

Locate well correctly on above Section Plat

Name of Conservation Agent who supervised plugging of this well W. L. Nichols, Morland, Kansas

Producing formation _____ Depth to top _____ Bottom _____ Total Depth of Well 3950 Feet

Show depth and thickness of all water, oil and gas formations.

OIL, GAS OR WATER RECORDS

CASING RECORD

FORMATION	CONTENT	FROM	TO	SIZE	PUT IN	PULLED OUT
				8-5/8"	184'	None

Describe in detail the manner in which the well was plugged, indicating where the mud fluid was placed and the method or methods used in introducing it into the hole. If cement or other plugs were used, state the character of same and depth placed, from _____ feet to _____ feet for each plug set.

Filled hole with heavy mud to 540'. Set plug. Put in 20 sacks cement & 1/2 sack hulls. Filled with heavy mud to 175'. Set plug. Put in 20 sacks cement & 1/2 sack hulls. Filled with heavy mud to 40'. Set plug. Filled to top with 10 sacks cement & 1/2 sack hulls.

RECEIVED
STATE CORPORATION COMMISSION
8-22-63
AUG 22 1963

CONSERVATION DIVISION
Wichita, Kansas


(If additional description is necessary, use BACK of this sheet)

Name of Plugging Contractor C-G Drilling Co.
Address 107 Rule Building, Wichita, Kansas

STATE OF KANSAS, COUNTY OF SEDGWICK, ss. G. F. Galloway (employee of owner) or (owner or operator) of the above-described well, being first duly sworn on oath, says: That I have knowledge of the facts, statements, and matters herein contained and the log of the above-described well as filed and that the same are true and correct. So help me God.

(Signature) G. F. Galloway
107 Rule Building
(Address)

SUBSCRIBED AND SWORN to before me this 20th day of August, 1963
My commission expires May 20, 1967
Vicky Jacobs Notary Public.

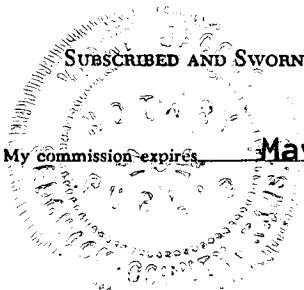

WELL LOG

OPERATOR D. G. Hansen
 WELL NAME Sparks #5
 TOTAL DEPTH 3950'
 COMM. August 7, 1963 COMP. August 15, 1963
 RIG NO. 1
 CASING: Set 184' (9 Jts) 8-5/8" OD Surface Casing
 SEC. 26-9-23W
 LOC. C SW/4
 COUNTY Graham
 STATE Kansas
 ELEVATION 2421 K.B.
 PRODUCTION: Dry & abandoned

All measurements taken from the top of rotary bushing.

FROM	TO	FORMATION	DEVIATION FROM VERTICAL	REMARKS:
0	810	Shale & Sand	500' --	1/2°
810	1290	Shale		
1290	1510	Sand & Shale	1500' --	3/4°
1510	1750	Sand		
1750	1915	Shale & Red Bed		
1915	1964	Red Bed		
1994	2005	Anhydrite	2000' --	3/4°
2005	2395	Shale & shells		
2395	2585	Shale & Lime	2500' --	1/2°
2585	3742	Lime & Shale	3500' --	1/2°
3742	3950	Lime		

DST #1 3863 - 3906

RECEIVED
 STATE CORPORATION COMMISSION

AUG 22 1963

CONSERVATION DIVISION
 Wichita, Kansas

STATE OF KANSAS)
 COUNTY OF SEDGWICK) SS.

The undersigned hereby certifies that to the best of his knowledge and belief, the above facts are true and correct.

C-G DRILLING CO.

By G. F. Galloway
 G. F. Galloway

SUBSCRIBED AND SWORN TO, BEFORE ME, THIS 20th day of August, 1963

My commission expires:
 May 20, 1967

Vicky Jacobs
 Vicky Jacobs - Notary Public