

STATE OF KANSAS
STATE CORPORATION COMMISSION

WELL PLUGGING RECORD

Give All Information Completely
Make Required Affidavit
Mail or Deliver Report to
Conservation Division
State Corporation Comm.
245 North Water
Wichita, KS 67202

Graham County. Sec. 28 Twp. 9s Rge. 23W&W
Location as "NE/CNW 1/4 SW 1/4" or footage from lines _____
NE SW SE


Lease Owner Arrowhead Petroleum, Inc.
Lease Name Rice Estate C Well No. 1
Office Address Box 8287, Munger Station, Wichita, KS
Character of Well (Completed as Oil, Gas or Dry Hole) _____
Dry Hole

Date Well completed 8-26-79 19
Application for plugging filed 1 8-26-79 19
Application for plugging approved 8-26-79 19
Plugging commenced 8-26-79 19
Plugging completed 8-26-79 19
Reason for abandonment of well or producing formation _____

Dry Hole
If a producing well is abandoned, date of last production _____
N/A 19

Was permission obtained from the Conservation Division or its agents before plugging was commenced? yes

Name of Conservation Agent who supervised plugging of this well Gil Balthazor
Producing formation _____ Depth to top _____ Bottom _____ Total Depth of Well 3980
Show depth and thickness of all water, oil and gas formations.

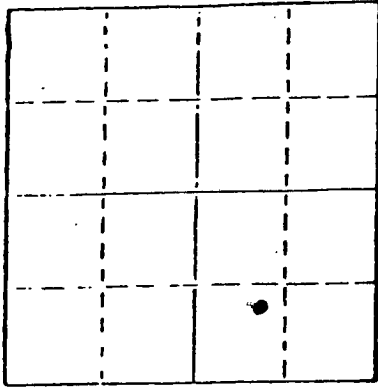

Locate well correctly on above Section Plat

OIL, GAS OR WATER RECORDS

CASING RECORD

FORMATION	CONTENT	FROM	TO	SIZE	PUT IN	PULLED OUT
Sand				8 5/8	210'	None

Describe in detail the manner in which the well was plugged, indicating where the mud fluid was placed and the method or methods used in introducing it into the hold. If cement or other plugs were used, state the character of same and depth placed, from _____ feet to _____ feet for each plug set.

70 sx 1000'
20 sx 200'
10 sx 40'
5 sx RH
50 - 50 PAZ 6% gel

(If additional description is necessary, use BACK of this sheet)

Name of Plugging Contractor _____ Service Company _____

STATE OF Kansas COUNTY OF Sedgwick, ss.
Paul A. Seymour, Jr. (employee of owner) or (owner or operator)
of the above-described well, being first duly sworn on oath, says: That I have knowledge of the facts, statements, and matters herein contained and the log of the above-described well as filed and that the same are true and correct. So help me God.

(Signature) Paul A. Seymour, Jr.
Box 8287, Munger Station, Wichita, KS 67202
(Address)

SUBSCRIBED AND SWORN TO before me this 30th day of August, 1979

Ruth M. Bassett
Ruth M. Bassett Notary Public.

My commission expires May 30, 1983

RECEIVED
STATE CORPORATION COMMISSION
8-31-79
AUG 31 1979
CONSERVATION DIVISION
Wichita, Kansas

BIG SPRINGS DRILLING, INC.

P.O. BOX 8287
MUNGER STATION
WICHITA, KANSAS 67208

SUITE 29 • 400 NORTH WOODLAWN • (316) 681-1732

August 30, 1979

DRILLER LOG

Re: Rice Estate "C" 1
NE SW SE
28 - 9s - 23W
Graham County, Kansas

OPERATOR: Arrowhead Petroleum, Inc.
CONTRACTOR: Big Springs Drilling, Inc.
COMMENCED: 8-20-79
COMPLETED: 8-26-79

Surface Pipe: 210' of 8 5/8" w/160 sx Common 2% gel 3% ccl

0	210	Clay, Shale and Sand
210	2037	Clay and Shale
2037	2078	Anhydrite
2078	3520	Shale and Shells
3520	3980	Lime
3980		RTD


RECEIVED
STATE CORPORATION COMMISSION
AUG 31 1979
CONSERVATION DIVISION
Wichita, Kansas

We certify that the above and foregoing is a true and correct copy of the log on the # 1 Rice Estate "C" located in Graham County, Kansas.

BIG SPRINGS DRILLING, INC.


Paul A. Seymour, Jr.

Subscribed and sworn to before me this 30th day of August, 1979.

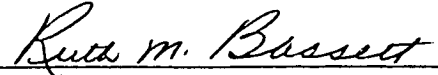
Ruth M. Bassett Notary Public

My Commission Expires:

May 30, 1983