

CARD MUST BE TYPED

State of Kansas
NOTICE OF INTENTION TO DRILL
(see rules on reverse side)

CARD MUST BE SIGNED

Starting Date: JANUARY 31 1985
month day year

API Number 15- 065-22,137-0000

OPERATOR: License # 5430

SE NW SW Sec 27 Twp 9 S, Rge 24 East
(location) West

Name ENERGY THREE, INC.

Address P. O. Box 1505

City/State/Zip GREAT BEND, KANSAS 67530

Contact Person CHARLES DIXON

Phone AC316-792-5968

1650 Ft North from Southeast Corner of Section
4290 Ft West from Southeast Corner of Section
(Note: Locate well on Section Plat on reverse side)

CONTRACTOR: License # 5836

Name BIG THREE DRILLING, INC.

City/State P.O. Box 52, GORHAM, KS. 67640

Nearest lease or unit boundary line 990 feet.

County GRAHAM

Lease Name EVA MOORE Well# 1

Well Drilled For: Well Class: Type Equipment:

- Oil Swd Infield Mud Rotary
- Gas Inj Pool Ext. Air Rotary
- OWWO Expl Wildcat Cable

Domestic well within 330 feet: yes no

Municipal well within one mile: yes no

If OWWO: old well info as follows:

Operator

Well Name

Comp Date Old Total Depth

Projected Total Depth 4250 feet

Projected Formation at TD LANSING-K.C.

Expected Producing Formations LANSING-KC.

Depth to Bottom of fresh water 200 feet

Lowest usable water formation DAKOTA

Depth to Bottom of usable water 1275 feet

Surface pipe by Alternate: 1 2

Surface pipe to be set 240 feet

Conductor pipe if any required feet

Ground surface elevation feet MSL

This Authorization Expires 7-22-85

Approved By 1-22-85 *[Signature]*

I certify that we will comply with K.S.A. 55-101, et seq., plus eventually plugging hole to K.C.C. specifications.

Date 1-17-85 Signature of Operator or Agent *[Signature]*


Title EXECUTIVE VICE-PRESIDENT

MHC/40HE 1-22-85

**Must be filed with the K.C.C. five (5) days prior to commencing well
This card void if drilling not started within six (6) months of date received by K.C.C.**

Important procedures to follow :

**A Regular Section of Land
1 Mile = 5,280 Ft.**

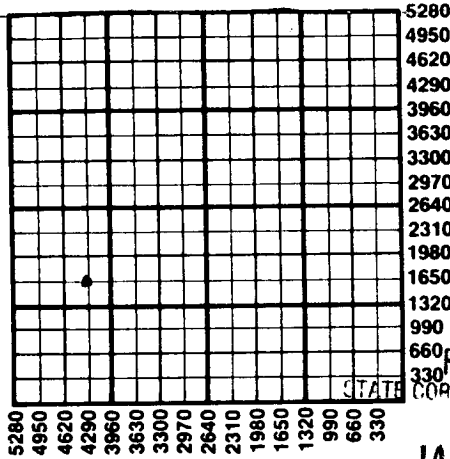

1. Notify District office before setting surface casing.
2. Set surface casing by circulating cement to the top.
3. File completion forms ACO-1 with K.C.C. within 90 days of well completion, following instructions on ACO-1, side 1, and including copies of wireline logs.
4. Notify District office 48 hours prior to old well workover or re-entry.
5. Prior to plugging, prepare a plugging plan, then obtain agreement from the appropriate district office for an approved plugging plan.
6. Submit plugging report (CP-4) to K.C.C. after plugging is completed.
7. Obtain an approved injection docket number before disposing of salt water.
8. Notify K.C.C. within 10 days when injection commences or terminates.

If an alternate 2 completion, cement in the production pipe from below any usable water to surface within 120 days of spud date.

RECEIVED
STATE CORPORATION COMMISSION

1-22-85

JAN 22 1985

CONSERVATION DIVISION
Wichita, Kansas

**State Corporation Commission of Kansas
Conservation Division
200 Colorado Derby Building
Wichita, Kansas 67202
(316) 263-3238**