

NOTICE OF INTENTION TO DRILL

(see rules on reverse side)

DV tool at 2200' to be cemented when production casing is set.

Starting Date January 5, 1986 month day year

API Number 15- 065-22,289-0000

OPERATOR: License # 5421

NE. SW. SW. Sec. 5 Twp. 9 S, Rg. 25 East West

Name Sage Drilling Co., Inc.

990 Ft. from South Line of Section

Address 202 S. St. Francis

4290 Ft. from East Line of Section

City/State/Zip Wichita, KS 67202

(Note: Locate well on Section Plat on reverse side)

Contact Person Casey Coats

Phone 316-263-6139

Nearest lease or unit boundary line 990 feet

CONTRACTOR: License # 5421

County Graham

Name Sage Drilling Co., Inc.

Lease Name Bittel Well # 1

City/State Wichita, KS 67202

Ground surface elevation 2530 (est) feet MSL

Well Drilled For: Well Class: Type Equipment:

X Oil SWD Infield X Mud Rotary

Gas Inj X Pool Ext Air Rotary

OWWO Expl Wildcat Cable

Domestic well within 330 feet: yes no

Municipal well within one mile: yes no

Surface pipe by Alternate: 1 2X

If OWWO: old well info as follows:

Operator

Depth to bottom of fresh water 200

Well Name

Depth to bottom of usable water 1400

Comp Date Old Total Depth

Surface pipe planned to be set 300

Projected Total Depth 4200 feet

Formation Lansing-Kansas City

I certify that well will comply with K.S.A. 55-101, et seq., plus eventually plugging hole to KCC specifications.


Date 12-24-85 Signature of Operator or Agent Casey Coats Title Petroleum Engineer

For KCC Use:

Conductor Pipe Required feet; Minimum Surface Pipe Required feet per Alt. 1 2

This Authorization Expires 6-26-86 Approved By [Signature]

A Regular Section of Land
1 Mile = 5,280 Ft.

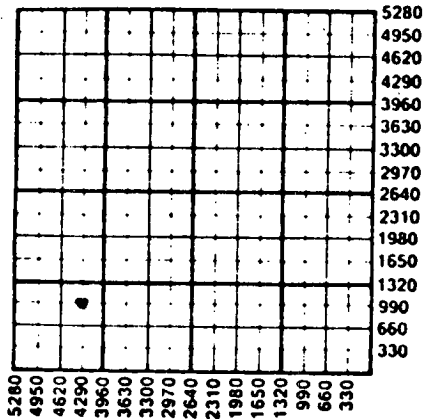

STATE OF

12-26-85
 DEC 26 1985

CONSERVATION DIVISION
 WICHITA, KANSAS

Important procedures to follow:

1. Notify District office before setting surface casing.
2. Set surface casing by circulating cement to the top.
3. File completion forms ACO-1 with K.C.C. within 90 days of well completion, following instructions on ACO-1, side 1, and including copies of wireline logs.
4. Notify District office 48 hours prior to old well workover or re-entry.
5. Prior to filing Intent, prepare a proposed plugging plan in case well is D & A, then obtain approval of plan when calling district office prior to setting surface pipe.
6. Submit plugging report (CP-4) to K.C.C. after plugging is completed.
7. Obtain an approved injection docket number before disposing of salt water.
8. Notify K.C.C. within 10 days when injection commences or terminates.
9. If an alternate 2 completion, cement in the production pipe from below any usable water to surface within 120 days of spud date.

State Corporation Commission of Kansas
Conservation Division
200 Colorado Derby Building
Wichita, Kansas 67202
(316) 263-3238