


15-065-00455-0000

STATE OF KANSAS
STATE CORPORATION COMMISSION

Give All Information Completely
Make Required Affidavit
Mail or Deliver Report to:
Conservation Division
State Corporation Commission
800 Bitting Building
Wichita, Kansas

WELL PLUGGING RECORD

NORTH

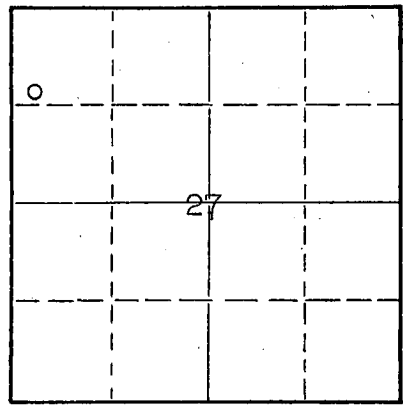

Locate well correctly on above Section Plat

Graham County. Sec. 27 Twp. 9S Rge. 24 ~~NE~~ W(W)
Location as "NE/CNW%SW%" or footage from lines NW NW SW
Lease Owner Imperial Drilling Company, Inc.
Lease Name Moore Well No. 1
Office Address 903 Union Natl Bank Bldg., Wichita 2, Kansas
Character of Well (completed as Oil, Gas or Dry Hole) Dry Hole
Date well completed August 17, 1954
Application for plugging filed August 17, 1954
Application for plugging approved August 17, 1954
Plugging commenced August 17, 1954
Plugging completed August 17, 1954
Reason for abandonment of well or producing formation No commercial shows of oil
If a producing well is abandoned, date of last production 19
Was permission obtained from the Conservation Division or its agents before plugging was commenced? yes

Name of Conservation Agent who supervised plugging of this well Warren H. Horner, Box 207, Great Bend, Ks.
Producing formation _____ Depth to top _____ Bottom _____ Total Depth of Well 4585 Feet
Show depth and thickness of all water, oil and gas formations.

OIL, GAS OR WATER RECORDS

CASING RECORD

FORMATION	CONTENT	FROM	TO	SIZE	PUT IN	PULLED OUT
				8-5/8"	225'	

Describe in detail the manner in which the well was plugged, indicating where the mud fluid was placed and the method or methods used in introducing it into the hole. If cement or other plugs were used, state the character of same and depth placed, from _____ feet to _____ feet for each plug set.

Set #1 plug at 200' with 20 sacks cement. Filled hole with rotary mud to 40', set #2 plug with 15 sacks cement.

(If additional description is necessary, use BACK of this sheet)

Name of Plugging Contractor Imperial Drilling Company, Inc.
Address 903 Union National Bank Building, Wichita 2, Kansas

STATE OF KANSAS, COUNTY OF SEDGWICK, ss.
Raymond L. Bacon (employee of owner) or (owner or operator) of the above-described well, being first duly sworn on oath, says: That I have knowledge of the facts, statements, and matters herein contained and the log of the above-described well as filed and that the same are true and correct. So help me God.

IMPERIAL DRILLING COMPANY, INC.
By: Ray L. Bacon Vice-Pres
Wichita, Kansas
(Address)

SUBSCRIBED AND SWORN TO before me this 25th day of August, 1954

My commission expires November 9, 1957

Marilyn E. Fox
Notary Public.

RECEIVED
STATE CORPORATION COMMISSION
8-26-54
AUG 26 1954

PLUGGING
FILE DEC 22 1954 R 24W
BOOK PAGE 58 LINE 4

CONSERVATION DIVISION
Wichita, Kansas

DRILLER'S LOG

Imperial Drilling Company, Inc.
903 Union National Bank Building
Wichita 2, Kansas

Moore #1
NW NW SW Sec. 27-9S-24W
Graham County, Kansas

Total Depth: 4585'

Commenced: 8-2-54 Completed: 8-17-54

Elevation: 2512' R.B.
Production: D & A

Contractor: Imperial Drilling Company, Inc.,
Wichita, Kansas

Casing Record: Set 8-5/8" Surface Pipe at 225' W/150 sacks cement.

Figures indicate bottom of formations:

Sand and Clay	222'		
Surface Clay	790'		
Sand and Shale	1195'	Anhydrite	2164' (/348)
Sandy Shale and Pyrites	1440'	Heebner	3817' (-1305)
Dakota Sand	1700'	Lansing	3851' (-1339)
Red Bed and Shells	2155'	Base Kansas City	4079' (-1567)
Shale and Shells	2164'	Marmaton	4195' (-1683)
Anhydrite (hard)	2208'	Conglomerate	4352' (-1840)
Shale and Shells	3195'	Mississippi	4374' (-1862)
Shale and Lime	3891'	Gilmore City	4442' (-1930)
Lime	4409'	Viola	4465' (-1953)
Lime (Cherty)	4446'	Arbuckle	4485' (-1973)
Lime	4585'	Total Depth	4585' (-2073)
Total Depth	4585'		

We hereby certify this to be a correct and accurate log of the above described well as shown on the daily drilling reports.

IMPERIAL DRILLING COMPANY, INC.

By: Raymond L. Bacon
Vice-President

Subscribed and sworn to before me this 25th day of August, 1954.

My Commission Expires:

November 9, 1957

Marilyn E. Fox
Notary Public

RECEIVED
STATE CORPORATION COMMISSION

AUG 26 1954

CONSERVATION DIVISION
Wichita, Kansas

PLUGGING
FILE SEC 27-9-24W
BOOK PAGE 58 LINE 4