

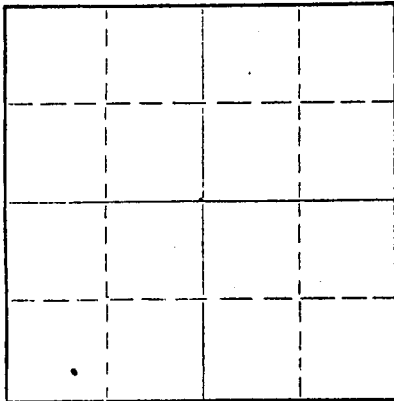
STATE OF KANSAS
STATE CORPORATION COMMISSION

Form CP-4

Give All Information Completely
Make Required Affidavit
Mail or Deliver Report to:
Conservation Division
State Corporation Commission
212 No. Market
Wichita, Kansas 67202

WELL PLUGGING RECORD

NORTH

Locate well correctly on above
Section Plat

Graham County, Sec. 27 Twp. 9 Rge. (E) 24 (W)
Location as "NE/CNW/SW" or footage from lines SE SW SW
Lease Owner Petroleum Management, Inc.
Lease Name Moore Well No. 2
Office Address Box 1325, Great Bend, Kansas 67530
Character of Well (completed as Oil, Gas or Dry Hole)
Date well completed 19_____
Application for plugging filed 1-21 19 74
Application for plugging approved 1-28 19 74
Plugging commenced 5-16 19 74
Plugging completed 5-16 19 74
Reason for abandonment of well or producing formation
If a producing well is abandoned, date of last production 19_____
Was permission obtained from the Conservation Division or its agents before plugging was commenced? Yes

Name of Conservation Agent who supervised plugging of this well W.L. Nichols
Producing formation Depth to top Bottom Total Depth of Well 4110 Feet
Show depth and thickness of all water, oil and gas formations.

OIL, GAS OR WATER RECORDS

CASING RECORD

FORMATION	CONTENT	FROM	TO	SIZE	PUT IN	PULLED OUT
				8 5/8	245'	
				4 1/2	4108'	1558'

Describe in detail the manner in which the well was plugged, indicating where the mud fluid was placed and the method or methods used in introducing it into the hole. If cement or other plugs were used, state the character of same and depth placed, from feet to feet for each plug set.

E 15310

Plug back with sand from TD to 3850'. Dumped 4 sx cement on plug with bailer.

Squeezed down hole with 5 sx hulls, 9 sx gel and 110 cubic feet cement from 1250' - 925'. 17 sx gel from 925' to 250'. 30 cubic feet cement from 250' to 175'.
4 sx gel from 175' to 25' to surface.

Plugged by Howco

RECEIVED
STATE CORPORATION COMMISSION
9-23-74
SEP 23 1974

CONSERVATION DIVISION
Wichita, Kansas

(If additional description is necessary, use BACK of this sheet)

Name of Plugging Contractor Midway Drilling, Inc. # 620
Address Box 921, Great Bend, Kansas 67530

STATE OF KANSAS, COUNTY OF SEDGWICK, ss.

DALE SILCOTT

(employee of owner) or (owner or operator) of the above-described well, being first duly sworn on oath, says: That I have knowledge of the facts, statements, and matters herein contained and the log of the above-described well as filed and that the same are true and correct. So help me God.

(Signature)

(Address)

SUBSCRIBED AND SWORN to before me this 20th day of September, 1974.
MARIE C. MURPHY, Notary Public
My commission expires April 23, 1979

Notary Public.