

15-065-00701-0000

STATE OF KANSAS
STATE CORPORATION COMMISSION


WELL PLUGGING RECORD

Give All Information Completely
Make Required Affidavit
Mail or Deliver Report to:
Conservation Division
State Corporation Commission
800 Bittling Building
Wichita, Kansas

Graham County. Sec. 27 Twp. 9S Rge. 24 (~~EX~~ W) (W)

Location as "NE/CNW/SW" or footage from lines SW SW SE
Lease Owner Coppinger Drilling, Inc.
Lease Name Nickelson Well No. 1
Office Address 320 Union National Bank Bldg., Wichita, Kansas.
Character of Well (completed as Oil, Gas or Dry Hole) Dry Hole
Date well completed 10-5 1955
Application for plugging filed 10-4 1955
Application for plugging approved 10-4 1955
Plugging commenced 10-4 1955
Plugging completed 10-5 1955
Reason for abandonment of well or producing formation Dry Hole

NORTH

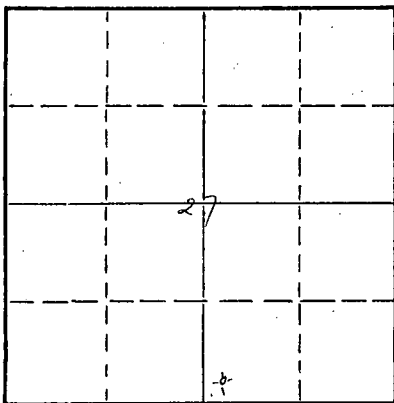

Locate well correctly on above
Section Plat

If a producing well is abandoned, date of last production none 19
Was permission obtained from the Conservation Division or its agents before plugging was commenced? Yes

Name of Conservation Agent who supervised plugging of this well Eldon Petty
Producing formation _____ Depth to top _____ Bottom _____ Total Depth of Well 4655 Feet
Show depth and thickness of all water, oil and gas formations.

OIL, GAS OR WATER RECORDS

CASING RECORD

FORMATION	CONTENT	FROM	TO	SIZE	PUT IN	PULLED OUT

Describe in detail the manner in which the well was plugged, indicating where the mud fluid was placed and the method or methods used in introducing it into the hole. If cement or other plugs were used, state the character of same and depth placed, from _____ feet to _____ feet for each plug set.

Filled hole with mud laden fluid to 210' of top.
Set plug at 210'
Cemented with 15 sacks
Set plug at 40'
Cemented with 10 sacks
Pumped plug down 7:30 a.m. 10-5-55

10-8-55

(If additional description is necessary, use BACK of this sheet)

Name of Plugging Contractor Coppinger Drilling, Inc.
Address 320 Union National Bank Bldg., Wichita, Kansas.

STATE OF KANSAS, COUNTY OF SEDGWICK, ss.
Lee Poulsen (employee of owner) or ~~owner~~ of the above-described well, being first duly sworn on oath, says: That I have knowledge of the facts, statements, and matters herein contained and the log of the above-described well as filed and that the same are true and correct. So help me God.

(Signature) Lee Poulsen
Lee Poulsen
320 Union Nat'l Bk. Bldg., Wichita, Kansas.
(Address)

SUBSCRIBED AND SWORN TO before me this 6th day of October, 1955

My commission expires March 7, 1956
Mayree Broadus Notary Public.

PLUGGING
FILE SEC 27-9R-24
BOOK PAGE 6 LINE 22

DRILLERS LOG

Coppinger Drilling, Inc., #1 Nickelson
SW SW SE Sec. 27-9s-21w
Graham County, Kansas

Drilling commenced: 9-19-55
Drilling completed: 10-5-55
Elevation: 2524' R.B.
2522' D.F.
2519' G.L.

Casing:

8-5/8" set at 228' w/175 sack cement

Tops: (Sample)

Native solids	50
Sand	145
Rock	180
Blue shale	228
Shale	700
Shale and shells	1230
Sand	1255
Sandy shale	1450
Shale and shells	1740
Sand and shale	1900
Red bed and shale	2090
Shale	2170
Anhydrite	2210
Shale	2230
Shale and shells	2455
Shale and lime	2695
Shale and broken lime	2850
Lime and shale	3015
Shale	3140
Lime and shale	3310
Lime	3375
Lime and shale	3470
Lime	3545
Lime and shale	3835
Lime	3915
Lime and shale	3954
Lime	4020
Lime and shale	4063
Lime	4077
Lime and shale	4180
Lime	4215
Lime and shale	4295
Lime	4345
Lime and shale	4395
Cherty lime	4459
Lime and shale	4509
Broken lime	4540
Lime	4625
Lime and shale	4655
R T D	4655
D & A	

Huebner	3836
Toronto	3860
Lansing	3874
Base Kansas City	4101
Marmaton	4191
Conglomerate	4371
Mississippi	4403
Gilmore City	4477
Kinderhook	4509
Viola	4522
Simpson	4598
Arbuckle	4610
R T D	4655

Dry and abandoned.

RECEIVED
OCT 8 - 1955
CONSERVATION DIVISION
Wichita, Kansas

STATE OF KANSAS, COUNTY OF SEDGWICK, SS.

I hereby certify that the above information is true and correct to the best of my knowledge.

Lee Paulsen

Subscribed and sworn to before me, a notary public, this 7th day of October 1955.

Mayree Broadus

Notary Public
(Mayree Broadus)

My commission expires:
March 7, 1956

PLUGGING
FILE SEC 27-9 R 24w
BOOK PAGE 6 LINE 22

