

STATE OF KANSAS
STATE CORPORATION COMMISSION

Form CP-4


Give All Information Completely
Make Required Affidavit
Mail or Deliver Report to:
Conservation Division
State Corporation Commission
212 No. Market
Wichita, Kansas

WELL PLUGGING RECORD

Graham County. Sec. 25 Twp. 9 Rge. (E) 24 (W)

Location as "NE/CNW%SW%" or footage from lines SE SE SE
Lease Owner Monarch Oil & Gas Company
Lease Name PETTETT Well No. 1
Office Address 1005 Wichita Plaza, Wichita, Kansas 67202
Character of Well (completed as Oil, Gas or Dry Hole) Dry Hole
Date well completed July 17, 1967
Application for plugging filed 19
Application for plugging approved 19
Plugging commenced July 17, 1967
Plugging completed July 17, 1967
Reason for abandonment of well or producing formation Dry Hole

NORTH

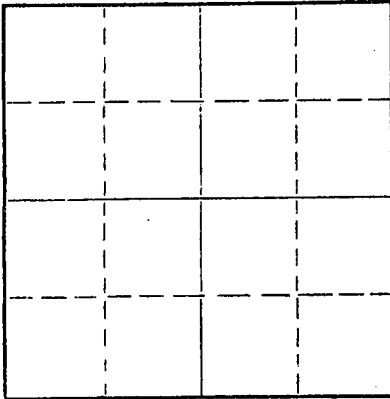

Locate well correctly on above
Section Plat

If a producing well is abandoned, date of last production 19
Was permission obtained from the Conservation Division or its agents before plugging was commenced? Yes (W.L. Nichols)

Name of Conservation Agent who supervised plugging of this well
Producing formation _____ Depth to top _____ Bottom _____ Total Depth of Well 4090 Feet
Show depth and thickness of all water, oil and gas formations.

OIL, GAS OR WATER RECORDS

CASING RECORD

FORMATION	CONTENT	FROM	TO	SIZE	PUT IN	PULLED OUT
	Surface	0	207'	8-5/8"	7/10/67	-----
	Casing					

Describe in detail the manner in which the well was plugged, indicating where the mud fluid was placed and the method or methods used in introducing it into the hole. If cement or other plugs were used, state the character of same and depth placed, from _____ feet to _____ feet for each plug set.

Heavy Mud from Total Depth to 1920 Feet;
111 sacks cement from 1575 feet to 1920
Feet thru the drill pipe; Plug @ 210'
with 20 sacks thru the drill pipe;
Mud to 40 feet; plug bridged with
kelly and 10 sacks cement to base of
cellar; 2 sacks cement in rat hole.
Job completed @ 9:00 A.M.

RECEIVED
STATE CORPORATION COMMISSION
7-20-67
JUL 20 1967

CONSERVATION DIVISION
Wichita, Kansas

(If additional description is necessary, use BACK of this sheet)

Name of Plugging Contractor Sage Drilling Co.
Address 500 Bitting Building, Wichita, Kansas

STATE OF KANSAS COUNTY OF SEDGWICK, ss.
Lawrence F. Gray of Sage Drilling Co. (employee of owner) or (owner or operator) of the above-described well, being first duly sworn on oath, says: That I have knowledge of the facts, statements, and matters herein contained and the log of the above-described well as filed and that the same are true and correct. So help me God.

(Signature) Lawrence F. Gray
500 Bitting Building, Wichita
(Address)

SUBSCRIBED AND SWORN to before me this 19th day of July, 1967.

Louise K. Whitted
Notary Public.

My commission expires November 26, 1970.

DRILLERS LOG

PETTETT NO. 1

CASING RECORD:	COMPANY:	Monarch Oil & Gas Co.	DESCRIPTION:
8-5/8" @ 207'	CONTRACTOR:	Sage Drilling Co.	SE SE SE
w/150 sax cement	COMMENCED:	July 10, 1967	Sec. 25-9S-24W.
TOTAL DEPTH:	COMPLETED:	July 17, 1967	Graham County, Kansas
4090'			ELEVATION: 2503KB

<u>FORMATION</u>	<u>FROM</u>	<u>TO</u>	<u>REMARKS</u>
Top Soil & Hard Sand	0	50	
Clay & Sand	50	170	
Shale	170	1180	
Sand	1180	1200	
Shale & Sand Streaks	1200	1675	
Dakota Sand	1675	1765	
Sand	1765	1885	
Shale & Sand	1885	2127	
Anhydrite	2127	2170	
Shale	2170	2695	
Shale & Lime	2695	2828	
Lime & Shale	2828	3058	
Lime	3058	3329	
Lime & Shale	3329	3570	
Shale & Lime	3570	3886	
Lime & Shale w/some Chert	3886	3938	
Lime	3938	4090	D&A

I certify that this is a true and correct copy of the above log to the best of my knowledge.

SAGE DRILLING CO., INC.

By Lawrence F. Gray
Lawrence F. Gray
 Lawrence F. Gray

Subscribed and sworn to before me this 19th day of July, 1967.

Louise K. Whitted
 Louise K. Whitted, Notary Public

My commission expires:
November 26, 1970.

RECEIVED
STATE CORPORATION COMMISSION

JUL 20 1967

CONSERVATION DIVISION
Wichita, Kansas