


15-065-00670-0000

STATE OF KANSAS
STATE CORPORATION COMMISSION

WELL PLUGGING RECORD

Give All Information Completely
Make Required Affidavit
Mail or Deliver Report to:
Conservation Division
State Corporation Commission
212 North Market, Insurance Bldg.
Wichita, Kansas

NORTH

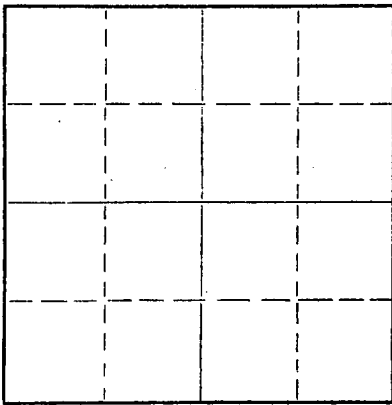

Locate well correctly on above
Section Plat

Graham County. Sec. 28 Twp. 9S Rge. (E) 24 (W)
Location as "NE/CNW&SW&" or footage from lines C SE SE SE
Lease Owner K & E DRILLING, INC.
Lease Name KOHART Well No. 1
Office Address 719 Union Center, Wichita 2, Kansas
Character of Well (completed as Oil, Gas or Dry Hole) Dry
Date well completed 9-22-61 19
Application for plugging filed 9-22-61 19
Application for plugging approved 9-22-61 19
Plugging commenced 9-22-61 19
Plugging completed 9-22-61 19
Reason for abandonment of well or producing formation Dry

If a producing well is abandoned, date of last production 19
Was permission obtained from the Conservation Division or its agents before plugging was commenced? Yes

Name of Conservation Agent who supervised plugging of this well Eldon Petty
Producing formation None Depth to top Bottom Total Depth of Well 4107 Feet
Show depth and thickness of all water, oil and gas formations.

OIL, GAS OR WATER RECORDS

CASING RECORD

FORMATION	CONTENT	FROM	TO	SIZE	PUT IN	PULLED OUT

Describe in detail the manner in which the well was plugged, indicating where the mud fluid was placed and the method or methods used in introducing it into the hole. If cement or other plugs were used, state the character of same and depth placed, from feet to feet for each plug set.

First plug set at 550' with 20 sx.
Second plug set at 240' with 20 sx.
Heavy mud to 40'
Third plug & 1/2 sack of Hulls, 10 sx. cement to surface.

Stamp: SEP 28 1961
Stamp: CONSERVATION DIVISION
Stamp: WICHITA, KANSAS


(If additional description is necessary, use BACK of this sheet)
Name of Plugging Contractor K & E DRILLING, INC.
Address 719 Union Center

STATE OF KANSAS, COUNTY OF SEDGWICK, ss.
H. L. Wilson (employee of owner) or (owner or operator) of the above-described well, being first duly sworn on oath, says: That I have knowledge of the facts, statements, and matters herein contained and the log of the above-described well as filed and that the same are true and correct. So help me God.

(Signature) H. L. Wilson
H. L. Wilson
719 Union Center, Wichita, Ks
(Address)

SUBSCRIBED AND SWORN to before me this 27th day of September, 19 61

My commission expires August 30, 1964
Julene M. Bannon
Julene M. Bannon Notary Public.

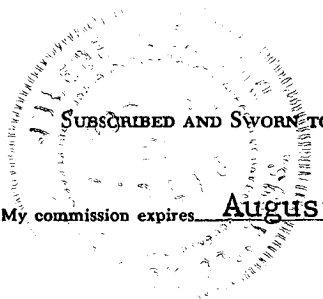

DRILLER'S WELL LOG

OPERATOR: **K & E DRILLING, INC.**
719 Union Center Building
Wichita 2, Kansas

WELL NAME: **#1 KOHART**
LOCATION: **C SE SE SE, Sec. 28-9S-24W**
GRAHAM COUNTY, KANSAS

CONTRACTOR: **K & E DRILLING, INC.**
719 UNION CENTER BLDG.
WICHITA, KANSAS

COMMENCED: **September 13, 1961**

CASING RECORD: **8-5/8" @ 255' w/175 sx**

COMPLETED: **September 22, 1961**

ELEVATION: **2529 Ground Level**
2531 DF 2534 KB

ROTARY TOTAL DEPTH: **4107'**

PRODUCTION: **Dry**

FORMATION RECORD

Depths shown indicate bottom of formations encountered.

Soil and clay	80
Sand	110
Sand and shale	257
Shale	1700
Sand	1935
Shale	2180
Anhydrite	2225
Shale	2385
Shale and shells	2655
Shale and lime	3350
Lime	3428
Shale and lime	3700
Lime	3781
Lime and shale	3850
Lime	4107 RTD

SEP 23 1961
CONSERVATION DIVISION
Wichita, Kansas

CERTIFICATION

State of KANSAS }
County of SEDGWICK } ss:

I, H. L. Wilson, of K&E DRILLING, INC., upon oath state that the above and foregoing is a true and correct copy of the Driller's Log of the above named well.

H. L. Wilson

Subscribed and sworn to before me this 27th day of September, 1961

Julene M. Bannan
Notary Public.

My Commission expires: August 30, 1964

