

15-065-20352-00-00

STATE OF KANSAS  
STATE CORPORATION COMMISSION

Form CP-4

Give All Information Completely  
Make Required Affidavit  
Mail or Deliver Report to:  
Conservation Division  
State Corporation Commission  
212 No. Market  
Wichita, Kansas 67202

WELL PLUGGING RECORD

Graham County, Sec. 28 Twp. 9 Rge. 24 (E) W (W)

Location as "NE/CNWxSWx" or footage from lines NE SW NW

Lease Owner Don E. Pratt Oil Operations

Lease Name Hoeting Well No. 2

Office Address P. O. Drawer 370, Hays, Kansas 67601

Character of Well (completed as Oil, Gas or Dry Hole) Dry Hole

Date well completed 8-1 1970

Application for plugging filed 8-1 1970

Application for plugging approved 8-1 1970


Plugging commenced 8-1 1970

Plugging completed 8-1 1970

Reason for abandonment of well or producing formation Dry Hole

If a producing well is abandoned, date of last production 19

Was permission obtained from the Conservation Division or its agents before plugging was commenced? Yes

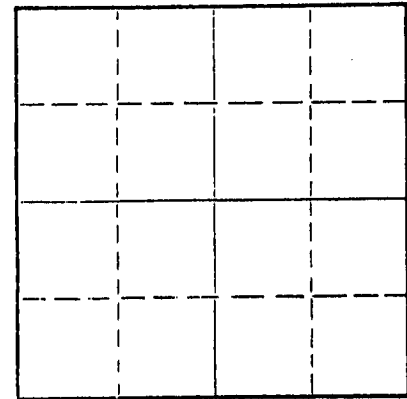

Locate well correctly on above  
Section Plat

Name of Conservation Agent who supervised plugging of this well Bill Nichols

Producing formation \_\_\_\_\_ Depth to top \_\_\_\_\_ Bottom \_\_\_\_\_ Total Depth of Well \_\_\_\_\_ Feet

Show depth and thickness of all water, oil and gas formations.

OIL, GAS OR WATER RECORDS

CASING RECORD

FORMATION	CONTENT	FROM	TO	SIZE	PUT IN	PULLED OUT
Surface Pipe				8 5/8"	273'	

Describe in detail the manner in which the well was plugged, indicating where the mud fluid was placed and the method or methods used in introducing it into the hole. If cement or other plugs were used, state the character of same and depth placed, from \_\_\_\_\_ feet to \_\_\_\_\_ feet for each plug set.

1st plug was set at 1240' with 100 cu. ft.

2nd plug was set at 310' with 20 cu. ft.

3rd plug was set at 40' with 10 cu. ft.

RECEIVED  
STATE CORPORATION COMMISSION  
AUG 4 1970  
CONSERVATION DIVISION  
Wichita, Kansas

(If additional description is necessary, use BACK of this sheet)

Name of Plugging Contractor L. J. Dreiling & Sons, Inc.


Address Victoria, Kansas 67671

STATE OF KANSAS, COUNTY OF ELLIS, ss.

I, Leo F. Dreiling (employee of owner) or (owner/proprietor) of the above-described well, being first duly sworn on oath, says: That I have knowledge of the facts, statements, and matters herein contained and the log of the above-described well as filed and that the same are true and correct. So help me God.

(Signature) Leo F. Dreiling  
LEO F. DREILING ROUTE 2, VICTORIA, KANSAS 67671  
(Address)

My commission expires September 19, 1970 3rd day of August, 19 70

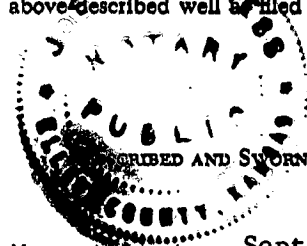

Joseph A. Hess  
JOSEPH A. HESS Notary Public.

