

# NOTICE OF INTENTION TO DRILL

(see rules on reverse side)

Starting Date 7-19-86  
month day year

API Number 15- 051-01053-0001

OPERATOR: License # 4794  
Name Big Bear Resources, Inc.  
Address 3000 Broadway - Suite C  
City/State/Zip Hays, Ks. 67601  
Contact Person Isidore P. Kisner  
Phone 913-625-1145

— East  
NW NE SE. Sec. 12 Twp. 11 S, Rg. 17  West  
2310' Ft. from South Line of Section  
290 990 Ft. from East Line of Section

(Note: Locate well on Section Plat on reverse side)

CONTRACTOR: License # 4083  
Name Western Ks. Drilling, Inc.  
City/State Hays, Ks. 67601

Nearest lease or unit boundary line 330' feet  
County Ellis

Lease Name Simpson Well # 4  
Ground surface elevation 1778 feet MSL

Well Drilled For: Well Class: Type Equipment:  
 Oil  SWD  Infield  Mud Rotary  
 Gas  Inj  Pool Ext.  Air Rotary  
 OWWO  Expl  Wildcat  Cable

Domestic well within 330 feet:  yes  no  
Municipal well within one mile:  yes  no  
Surface pipe by Alternate:  ~~1~~

If OWWO: old well info as follows:  
Operator Leben Drilling  
Well Name Cress #1  
Comp Date 11-29-57 Old Total Depth 3336'

Depth to bottom of fresh water 200'  
Depth to bottom of usable water Dakota 600' 2"  
Surface pipe ~~plumb~~ set 980'  
Projected Total Depth 3500' feet  
Formation Arb.

I certify that well will comply with K.S.A. 55-101, et seq., plus eventually plugging hole to KCC specifications.

Date 7-10-86 Signature of Operator or Agent Isidore P. Kisner Title Operator


For KCC Use:  
Conductor Pipe Required \_\_\_\_\_ feet; Minimum Surface Pipe Required \_\_\_\_\_ feet per Alt. 600  
This Authorization Expires 1-14-87 Approved By [Signature] 7-14-86

Must be filed with the K.C.C. five (5) days prior to commencing well  
This card void if drilling not started within six (6) months of date received by K.C.C.

**Important procedures to follow:**

1. Notify District office before setting surface casing.
2. Set surface casing by circulating cement to the top.
3. File completion forms ACO-1 with K.C.C. within 90 days of well completion, following instructions on ACO-1, side 1, and including copies of wireline logs.
4. Notify District office 48 hours prior to old well workover or re-entry.
5. Prior to filing Intent, prepare a proposed plugging plan in case well is D & A, then obtain approval of plan when calling district office prior to setting surface pipe.
6. Submit plugging report (CP-4) to K.C.C. after plugging is completed.
7. Obtain an approved injection docket number before disposing of salt water.
8. Notify K.C.C. within 10 days when injection commences or terminates.
9. If an alternate 2 completion, cement in the production pipe from below any usable water to surface within 120 days of spud date.

**A Regular Section of Land**  
1 Mile = 5,280 Ft.

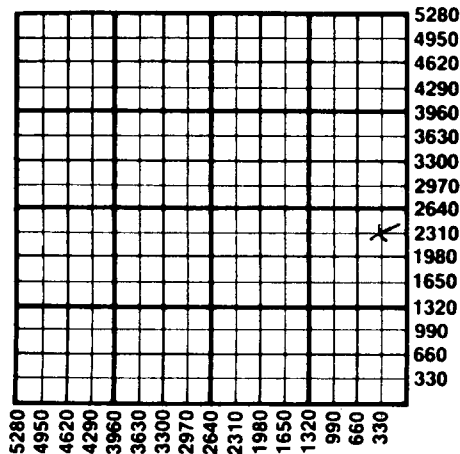

RECEIVED  
STATE CORPORATION COMMISSION

7-14-1986  
JUL 14 1986

CONSERVATION DIVISION  
Wichita, Kansas

State Corporation Commission of Kansas  
Conservation Division  
200 Colorado Derby Building  
Wichita, Kansas 67202  
(316) 263-3238