

CARD MUST BE TYPED

State of Kansas

CARD MUST BE SIGNED

NOTICE OF INTENTION TO DRILL

(see rules on reverse side)

Starting Date 5 9 86
 month day year

API Number 15- 051-24,409-00-00

OPERATOR: License # 4794
Name Big Bear Resources, Inc.
Address 3000 Broadway - Suite C
City/State/Zip Hays, Kansas 67601
Contact Person Isaidore P. Kisner
Phone 913 625-1145

_____ East
NW SW SE Sec 12 Twp 11 S, Rg 17 X West
890' Ft. from South Line of Section
2310' Ft. from East Line of Section

(Note: Locate well on Section Plat on reverse side)

CONTRACTOR: License # 4083
Name Western Kansas Drilling Inc
City/State 1111 E. 30th. Box 126, Hays, Ks 67601

Nearest lease or unit boundary line 330' feet
County Ellis
Lease Name Simpson Well # 2

Well Drilled For: Well Class: Type Equipment:
 Oil SWD Infield Mud Rotary
 Gas Inj Pool Ext. Air Rotary
 OWWO Expl Wildcat Cable

Ground surface elevation feet MSL
Domestic well within 330 feet: yes no
Municipal well within one mile: yes no
Surface pipe by Alternate: 1 X 2 4
Depth to bottom of fresh water 300
Depth to bottom of usable water 800
Surface pipe planned to be set 1000'
Projected Total Depth 3390 feet
Formation K.C. Arb

If OWWO: old well info as follows:
Operator
Well Name
Comp Date Old Total Depth

I certify that well will comply with K.S.A. 55-101, et seq., plus eventually plugging hole to KCC specifications.

PCA/KONE

Date 5-2-86 Signature of Operator or Agent Isaidore P. Kisner Title Operator


For KCC Use:
Conductor Pipe Required feet; Minimum Surface Pipe Required 500 feet per Alt 1
This Authorization Expires 11-6-86 Approved By 5-6-86

Must be filed with the K.C.C. five (5) days prior to commencing well
This card void if drilling not started within six (6) months of date received by K.C.C.

Important procedures to follow:

1. Notify District office before setting surface casing.
2. Set surface casing by circulating cement to the top.
3. File completion forms ACO-1 with K.C.C. within 90 days of well completion, following instructions on ACO-1, side 1, and including copies of wireline logs.
4. Notify District office 48 hours prior to old well workover or re-entry.
5. Prior to filing Intent, prepare a proposed plugging plan in case well is D & A, then obtain approval of plan when calling district office prior to setting surface pipe.
6. Submit plugging report (CP-4) to K.C.C. after plugging is completed.
7. Obtain an approved injection docket number before disposing of salt water.
8. Notify K.C.C. within 10 days when injection commences or terminates.

A Regular Section of Land 1 Mile = 5,280 Ft.

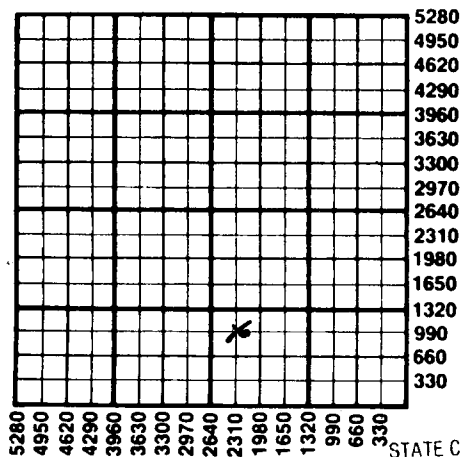

RECEIVED
STATE CORPORATION COMMISSION

MAY 06 1986
5-6-1986
CONSERVATION DIVISION
Wichita, Kansas

on alternate 2 completion, cement in the production pipe from below any usable water to surface within 120 days of spud date.

State Corporation Commission of Kansas
Conservation Division
200 Colorado Derby Building
Wichita, Kansas 67202
(316) 263-3238