


15-193-20127-00-00

STATE OF KANSAS
STATE CORPORATION COMMISSION

WELL PLUGGING RECORD

Give All Information Completely
Make Required Affidavit
Mail or Deliver Report to
Conservation Division
State Corporation Comm.
245 North Water
Wichita, KS 67202

Thomas County. Sec. 9 Twp. 10 Rge. 33W E/W
Location as "NE/CNW 1/4 SW 1/4" or footage from lines
C NE SW
Lease Owner Donald C. Slawson & Petroleum, Inc.
Lease Name Nollette 'M' Well No. 2
Office Address 408 120 Building, Wichita, Kansas 67202
Character of Well (Completed as Oil, Gas or Dry Hole)
dry hole

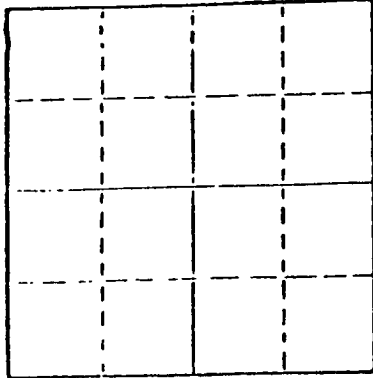

Locate well correctly on above
Section Plot

Date Well completed March 28 1977
Application for plugging filed March 28 1977
Application for plugging approved March 28 1977
Plugging commenced March 28 1977
Plugging completed March 28 1977
Reason for abandonment of well or producing formation
dry hole

If a producing well is abandoned, date of last production
19

Was permission obtained from the Conservation Division or
its agents before plugging was commenced? yes

Name of Conservation Agent who supervised plugging of this well Gilbert Balthazor
Producing formation _____ Depth to top _____ Bottom _____ Total Depth of Well 4450'
Show depth and thickness of all water, oil and gas formations.

OIL, GAS OR WATER RECORDS

CASING RECORD

FORMATION	CONTENT	FROM	TO	SIZE	PUT IN	PULLED OUT
8 5/8"	323				331	

Describe in detail the manner in which the well was plugged, indicating where the mud fluid
was placed and the method or methods used in introducing it into the hold. If cement or other
plugs were used, state the character of same and depth placed, from _____ feet to
_____ feet for each plug set.

1st plug @ 1650' w/70 sx
2nd plug @ 325' w/20 sx
Top plug @ 40' w/10 sx

04-22-1977

(If additional description is necessary, use BACK of this sheet)

Name of Plugging Contractor Slawson Drilling Company, Inc.

STATE OF Kansas COUNTY OF Sedgwick, ss.
R.J. Thatcher (employee of owner) or (owner or operator)
of the above-described well, being first duly sworn on oath, says: That I have knowledge of
the facts, statements, and matters herein contained and the log of the above-described well
as filed and that the same are true and correct. So help me God.

(Signature)

R.J. Thatcher
408 120 Building, Wichita, Kansas 67202
(Address)

SUBSCRIBED AND SWORN TO before me this 20th day of April, 19 77

MarGene Hamer
MarGene Hamer

Notary Public.

My commission expires 11/9/80



15-193-20127-00-00

WELL LOG

OPERATOR: Donald C. Slawson and Petroleum, Inc.
 408 One Twenty Building
 Wichita, Kansas 67202

LEASE: #2 Nollette 'M'
 C NE SW Sec. 9-10-33W
 Thomas County, Kansas

CONTRACTOR: Slawson Drilling Company, Inc.

COMMENCED: March 21, 1977

COMPLETED: March 28, 1977

CASING: Surface - 8 5/8" @ 331' w/225 sx 60/40 poz

0 - 334	Surface hole
334 - 994	Shale and Shells
994 - 2132	Shale and Sand
2132 - 2182	Shale and Shells
2182 - 2610	Shale and Sand
2610 - 2700	Shale and Shells
2700 - 2740	Anhydrite
2740 - 3008	Shale and Sand
3008 - 4145	Shale and Lime
4145 - 4450	Lime
4450	RTD

APR 22 1977

STATE OF KANSAS)
) SS.
 COUNTY OF SEDGWICK)

I, R.J. Thatcher, of the Slawson Drilling Company, Inc. upon oath state that the above and foregoing is a true and correct copy of the log of the #2 Nollette 'M' well.

R.J. Thatcher

 R.J. Thatcher

Subscribed and sworn to before me this 20th day of April, 1977.

MarGene Hamer

 MarGene Hamer, Notary Public

My Commission Expires: 11/9/80

