


STATE OF KANSAS
STATE CORPORATION COMMISSION

Give All Information Completely
Make Required Affidavit
Mail or Deliver Report to:
Conservation Division
State Corporation Commission
211 No. Broadway
Wichita, Kansas

WELL PLUGGING RECORD
15-143-00001 - 00-00

Ottawa County. Sec. 5 Twp. 11 Rge. 1 (X) (W)
Location as "NE/CNW/SW" or footage from lines SW SW SW
Lease Owner Rupp-Ferguson Oil Co.
Lease Name Bingham Well No. 1
Office Address 522 Union Center Bldg., Wichita, Kansas
Character of Well (complete as Oil, Gas or Dry Hole) Dry Hole
Date well completed 3-8-57 19__
Application for plugging filed 3-8-57 19__
Application for plugging approved 3-8-57 19__
Plugging commenced 3-8-57 19__
Plugging completed 3-8-57 19__
Reason for abandonment of well or producing formation _____

NORTH

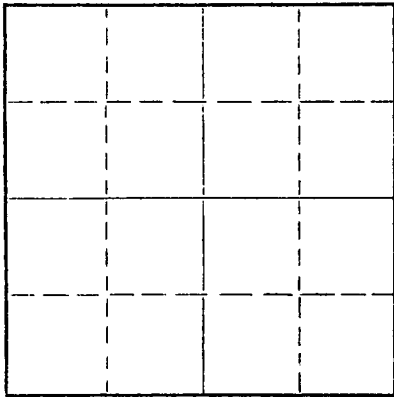

Locate well correctly on above
Section Plat

If a producing well is abandoned, date of last production _____ 19__
Was permission obtained from the Conservation Division or its agents before plugging was commenced? Yes

Name of Conservation Agent who supervised plugging of this well Milton Galyardt, Box 145, Russell, Kansas
Producing formation _____ Depth to top _____ Bottom _____ Total Depth of Well 3610 Feet
Show depth and thickness of all water, oil and gas formations.

OIL, GAS OR WATER RECORDS

CASING RECORD

FORMATION	CONTENT	FROM	TO	SIZE	PUT IN	PULLED OUT
				8 5/8	227	0

Describe in detail the manner in which the well was plugged, indicating where the mud fluid was placed and the method or methods used in introducing it into the hole. If cement or other plugs were used, state the character of same and depth placed, from _____ feet to _____ feet for each plug set.

Fill hole with mud to 220' 1/2 sx hulls - plug - 20 s x cement thru D.P. mud to 40' 1/2 sx hulls - cem. to base of cellar

(If additional description is necessary, use BACK of this sheet)
Name of Plugging Contractor Rupp-Ferguson Oil Co.
Address 522 Union Center Bldg. Wichita, Kansas

STATE OF Kansas COUNTY OF Sedgwick, ss.
L. W. Knox (employee of owner) or (owner or operator) of the above-described well, being first duly sworn on oath, says: That I have knowledge of the facts, statements, and matters herein contained and the log of the above-described well as filed and that the same are true and correct. So help me God.

(Signature) L. W. Knox
522 Union Center Bldg., Wichita, Kansas
(Address)

SUBSCRIBED AND SWORN to before me this 13 day of March, 19 57
My commission expires June 4, 1959
Helen Horine Notary Public.

RECEIVED
CONSERVATION DIVISION
MAR 16 1957
Wichita, Kansas

PLUGGING
FILE SEC 5 T 11 R 10
BOOK PAGE 146 LINE 42

15-143-00001-00-00

CONTRACTOR'S WELL LOG

Rupp-Ferguson No. 1 Bingham
SW SW SW Sec. 5-11-1W
Ottawa County, Kansas

D & A

Elevation 1337 KB

Commenced: 2-26-57
Completed: 3-8-57
Contractor: Rupp-Ferguson Oil Co.

Set 227' of 8 5/8" surface casing w/120 sacks

Figures Indicate Bottom of Formation

270	Lime and shale
465	Lime (shale strks.)
620	Lime
760	Lime
995	Lime and shale
1210	Lime and shale
1460	Lime and shale
1732	Shale and lime
1882	Lime and shale
2030	Lime and shale
2185	Lime and shale
2280	Lime
2356	Lime and shale
2449	Lime and shale
2578	Lime and shale
2705	Lime and shale
2800	Miss.
2856	Miss.
2897	Miss.
2974	Kinderhook
3075	Hunton
3146	Hunton
3254	Hunton
3365	Lime and shale
3460	Viola
3567	Simpson
3610	Arbuckle T.D.

PLUGGING	
WELL SEC.	5 11 R1
BOOK PAGE	146 LINE 42

STATE OF KANSAS } SS
COUNTY OF SEDGWICK }

03-14-1957

I, L. W. Knox, Landman for Rupp-Ferguson Oil Co., do hereby certify that the above and foregoing is a true and correct copy of the log of the No. 1 Bingham.

L. W. Knox
L. W. Knox

Subscribed and sworn to before me this 13th day of March, 1957

My commission Expires June 4, 1959

Helen Horine
Notary Public