


Give All Information Completely
Make Required Affidavit
Mail or Deliver Report to:
Conservation Division
State Corporation Commission
800 Bitting Building
Wichita, Kansas

OR
FORMATION PLUGGING RECORD

Strike out upper line
when reporting plug-
ging of formations.

Ottawa County. Sec. 27 Twp. 11 Rge. 2 (~~10~~) (W)
Location as "NE $\frac{1}{4}$ NW $\frac{1}{4}$ SW $\frac{1}{4}$ " or footage from lines. SE SE SE
Lease Owner H. B. Peatling
Lease Name Quinn Well No. 1
Office Address Salina, Kansas
Character of Well (completed as Oil, Gas or Dry Hole) DRY
Date well completed August 26 19 46
Application for plugging filed August 26 19 46
Application for plugging approved August 26 19 46
Plugging commenced August 26 19 46
Plugging completed August 26 19 46
Reason for abandonment of well or producing formation
DRY
If a producing well is abandoned, date of last production..... 19.....
Was permission obtained from the Conservation Division or its agents before plugging was com-
menced? yes---oral

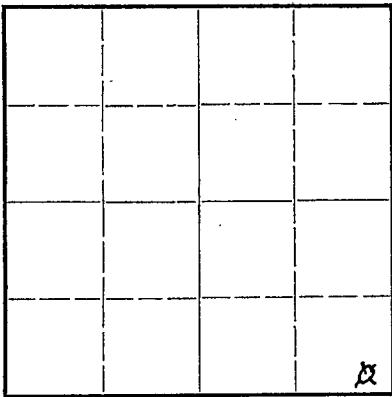

Locate well correctly on above
Section Plat

Name of Conservation Agent who supervised plugging of this well R. L. Durkee
Producing formation..... Depth to top..... Bottom..... Total Depth of Well 3655 Feet
Show depth and thickness of all water, oil and gas formations.

OIL, GAS OR WATER RECORDS

CASING RECORD

Formation	Content	From	To	Size	Put In	Pulled Out
				8 5/8"	170 ft.	None

Describe in detail the manner in which the well was plugged, indicating where the mud fluid was placed and the method or methods used in introducing it into the hold. If cement or other plugs were used, state the character of same and depth placed, from.....feet to.....feet for each plug set.

Filled hole full mud to within 170 feet of top. Drove wooden plug to 170 ft. of top and bridged, dumped in 15 sacks of cement. Finished filling hole full heavy mud to within 15 ft. of top of cellar and put in 5 sacks of cement.

27 11 SW
68 27

(If additional description is necessary, use BACK of this sheet)


Correspondence regarding this well should be addressed to H. B. Peatling
Address Salina, Kansas

STATE OF Kansas, COUNTY OF Ottawa Sedgwick, ss.
C. C. Nelson -- Operator (employee of owner) or (owner or operator) of the above-described well,
being first duly sworn on oath, says: That I have knowledge of the facts, statements, and matters herein contained and the log of the above-described well as filed and that the same are true and correct. So help me God.

(Signature) C. C. Nelson - Contractor

SUBSCRIBED AND SWORN to before me this 29th day of August 19 46

My commission expires May 25, 1949
Esther Russell
Notary Public.

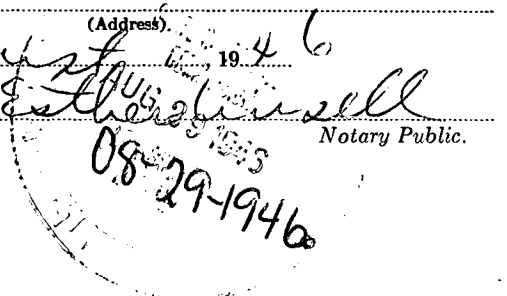

15-143-00013-00-00

COMPANY: H. B. Peatling
 CONTRACTOR: C. C. Nelson Drilling Company
 FARM: Quinn #1
 LOCATION: SE SW SE Sec. 27-11S-R2
 Ottawa County, Kansas
 COMMENCED: August 13, 1946
 COMPLETED: August 26, 1946

0	to	55	Sand
55	to	166	Shale and shells
166	to	260	Shale and shells
260	to	325	Anhydrate
325	to	355	Lime
355	to	600	Lime and shale
600	to	630	Sand
630	to	725	Lime and shale
725	to	750	Sandy lime
750	to	765	Hard sand
765	to	830	Shale and sand
830	to	895	Shale and lime
895	to	1040	Red bed and shale
1040	to	1470	Shale and shells
1470	to	1805	Shale
1850	to	1840	Lime
1840	to	1880	Shale
1880	to	1965	Lime
1965	to	2110	Shale
2110	to	2420	Lime
2420	to	2660	Lime and shale
2660	to	2703	Shale and shells
2703	to	2925	Lime and chert
2925	to	3035	Lime and shale
3035	to	3106	Shale
3106	to	3110	Lime--hard
3110	to	3225	Lime
3225	to	3250	Shale
3250	to	3544	Lime
3544	to	3585	Simpson sand
3585	to	3645	Arbuckle
3645	to	3655	Lime
		3655	T.D.

C E R T I F I C A T E

Set 170 ft. of 8 5/8 inch surface pipe. Cemented with 100 sacks of cement.

Top of Arbuckle 3623
 Top of Mississippi 2703
 Top of Simpson 3544

27 11 SW
 68 27

DRY, ABANDONED AND PLUGGED

08-29-1946

I, C. C. Nelson, do hereby certify that the above and foregoing is a true and correct copy of log of the Quinn #1, Sec. 27-11S-R2, Ottawa County, Kansas, as reflected by files of the Nelson Drilling Company.

C. C. Nelson

Subscribed and sworn to before me a Notary Public of Sedgwick County, Kansas, this 29 day of August 1946.
 My commission expires March 25, 1949

Walter J. ...