


Give All Information Completely
Make Required Affidavit
Mail or Deliver Report to:
Conservation Division
State Corporation Commission
800 Bitting Building
Wichita, Kansas

OR
FORMATION PLUGGING RECORD

Strike out upper line
when reporting plugging
of formations.

NORTH

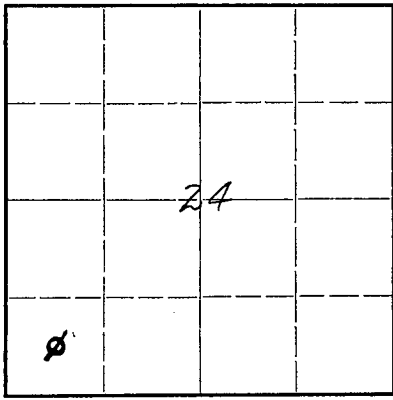

Locate well correctly on above
Section Plat

Lincoln County. Sec. 24 Twp. 11S. Rge. (E) 7 (W)
Location as "NE $\frac{1}{4}$ NW $\frac{1}{4}$ SW $\frac{1}{4}$ " or footage from lines SW $\frac{1}{4}$ SW $\frac{1}{4}$
Lease Owner. The Dickey Oil Company
Lease Name. Eckart Well No. 1
Office Address. Wichita, Kansas
Character of Well (completed as Oil, Gas or Dry Hole) Dry Hole
Date well completed. May 22, 1944
Application for plugging filed. April 28, 1944
Application for plugging approved. Verbal approval 4/28/44; written 5/4 1944
Plugging commenced. April 28, 1944
Plugging completed. May 5, 1944
Reason for abandonment of well or producing formation. Dry Hole

If a producing well is abandoned, date of last production. 19...
Was permission obtained from the Conservation Division or its agents before plugging was commenced? Yes

Name of Conservation Agent who supervised plugging of this well. Ruhl Durke
Producing formation. Depth to top. Bottom. Total Depth of Well. Feet
Show depth and thickness of all water, oil and gas formations.


OIL, GAS OR WATER RECORDS

CASING RECORD

Formation	Content	From	To	Size	Put In	Pulled Out

Describe in detail the manner in which the well was plugged, indicating where the mud fluid was placed and the method or methods used in introducing it into the hold. If cement or other plugs were used, state the character of same and depth placed, from...feet to...feet for each plug set.

Circulate heavy mud to bottom 4144'; pulled up to 2000', circulated heavy mud. Set cement plug at 250' with twenty sacks Ash Grove Cement. Filled to top with heavy mud and cemented top of surface with five sacks Ash Grove Cement. Cut off top of surface casing and welded steel plate on top of 10" surface casing below plow depth.

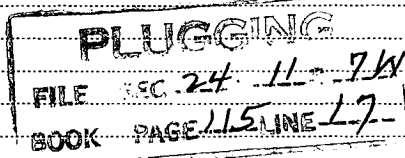

(If additional description is necessary, use BACK of this sheet)


Correspondence regarding this well should be addressed to. The Dickey Oil Company
Address. 713 Petroleum Building, Wichita 2, Kansas

STATE OF Kansas, COUNTY OF Sedgwick, ss.
Wayne Bradley (employee of owner) of the above-described well,
being first duly sworn on oath, says: That I have knowledge of the facts, statements, and matters herein contained and the log of the above-described well as filed and that the same are true and correct. So help me God.

(Signature) Wayne Bradley

SUBSCRIBED AND SWORN TO before me this 26th day of June 1944

My commission expires August 31, 1946

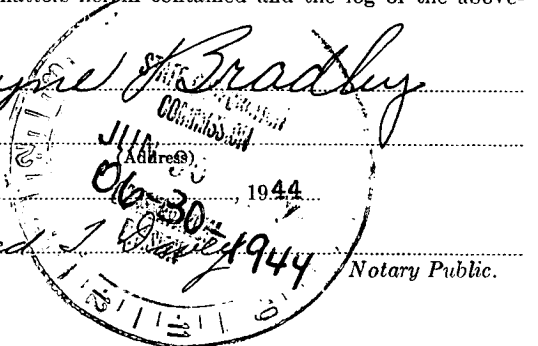

15-105-00001-00-00

THE DICKEY OIL COMPANY
LOG OF EKKART NO. 1 WELL

COMMENCED: March 25, 1944
COMPLETED: April 26, 1944

LOCATION: C SW₄ S₄ SW₄
24-11-7
Lincoln Co., Kans.

Casing Record

350' 10"

shale, part rock	45
shale and shells	215
sand and shells	240
shale and shells	488
red-bed	575
shale and shells	1085
salt, shale and lime	1240
shale and shells	1490
shale and lime	1575
broken lime	1700
shale and lime	1960
shale and shells	2080
shale and lime	2145
broken lime	2235
shale and shells	2312
broken lime	2390
lime	2395
sandy lime	2401
broken lime	2682
shale - blue	2708
broken lime	2818
lime	2830
shale and lime	2870
broken lime	2975
shale and lime	3065
broken lime	3115
shale and lime	3145
broken lime	3175
lime	3245
shale and lime	3272
shale	3385
conglomerate	3393
chat	3562
shale and lime	3615
shale	3666
chat and lime	3677
chert and shale	3714
chert	3742
shale	3840
lime	3860
lime and shale	3920
lime	3975
shale	4010
top of simpson	4016
lime and shale	4037
conglomerate	4050
lime and sand	4075
top of arbuckle lime	4081
lime	4115
lime and chert	4144
Total Depth	4144

24 11 - 7W
115 17

06-30-1944