


WELL PLUGGING RECORD

Give All Information Completely
Make Required Affidavit
Mail or Deliver Report to:
Conservation Division
State Corporation Commission
800 Bittling Building
Wichita, Kansas

NORTH

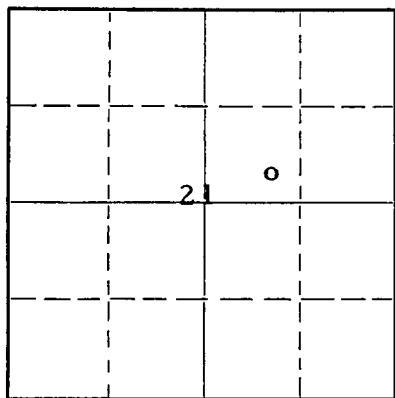

Locate well correctly on above
Section Plat

Lincoln County, Sec. 21 Twp. 11 Rge. (E) 8 (W)
Location as "NE/CNW $\frac{1}{4}$ SW $\frac{1}{4}$ " or footage from lines 330' FSL & 1650' FEL of NE/4
Lease Owner Kewanee Oil Company
Lease Name Crawford Well No. 1
Office Address P. O. Box 2093, Wichita 1, Kansas
Character of Well (completed as Oil, Gas or Dry Hole) Dry Hole
Date well completed 11-6 19 58
Application for plugging filed 11-5 19 58
Application for plugging approved (Verbal) 11-5 19 58
Plugging commenced 11-6 19 58
Plugging completed 11-6 19 58

Reason for abandonment of well or producing formation Dry Hole
If a producing well is abandoned, date of last production 19
Was permission obtained from the Conservation Division or its agents before plugging was commenced? Yes

Name of Conservation Agent who supervised plugging of this well Mr. Don Truan, Gorham, Kansas
Producing formation Depth to top Bottom Total Depth of Well 520 Feet
Show depth and thickness of all water, oil and gas formations.

OIL, GAS OR WATER RECORDS

CASING RECORD

Formation	Content	From	To	Size	Put In	Pulled Out
	Dry	0	520	8-5/8"	516	0

Describe in detail the manner in which the well was plugged, indicating where the mud fluid was placed and the method or methods used in introducing it into the hole. If cement or other plugs were used, state the character of same and depth placed, from...feet to...feet for each plug set.

Filled with mud from 520' to 300'
Halliburton plug @ 300'
20 sacks cement from 300' to 240'
Filled with mud from 240' to 40'
Halliburton plug set at 40'
10 sacks cement from 40' to surface

RECEIVED
STATE CORPORATION COMMISSION

NOV 7
11-07-1958

(If additional description is necessary, use BACK of this sheet)

Correspondence regarding this well should be addressed to Kewanee Oil Company
Address P. O. Box 2093, Wichita 1, Kansas

STATE OF KANSAS, COUNTY OF SEDGWICK, ss.

Robert Gray (employee of owner) or (owner or operator) of the above-described well, being first duly sworn on oath, says: That I have knowledge of the facts, statements, and matters herein contained and the log of the above-described well as filed and that the same are true and correct. So help me God.

(Signature) Robert Gray
P. O. Box 2093, Wichita 1, Kansas
(Address)

SUBSCRIBED AND SWORN to before me this 6th day of November, 19 58

Sam B. McNeill
Notary Public.

My commission expires August 2, 1961

PLUGGING
FILE SEC 21 T 11 R 3W
BOOK PAGE 143 LINE 29

15-105-00032-00-00

KEWANEE OIL COMPANY

Well Record: Crawford #1

Elevation: 1581' CM

Located: 330' FSL & 1650' FEL of NE/4 Sec. 21-11S-8W,
Lincoln County, Kansas

Drilling Commenced: 11-3-58

Drilling Completed: 11-4-58

Completion Date: 11-6-58

Total Depth: 520'

Treating Record: Was not treated

Perforating Record: Was not perforated

Initial Production: Plugged & Abandoned

FORMATION TOPS

None

CASING RECORD

8-5/8" O. D. casing cemented @ 516.38' with 350 sacks
pozmix, 1/4# flocele per sack & 2% c. c.

FORMATION RECORD

0	-	Surface
40	-	Shale & lime
200	-	Shale & shells
260	-	Shale & sand streaks
303	-	Shale & shells
444	-	Sand
520	-	Shale & shells

PLUGGING

FILE SEC. 21 T. 11 R. 8W
BOOK PAGE 143 LINE 29

WELLS
STATE CORP.

11-07-1958

WELLS STATE CORP.
Lincoln, Kansas