


STATE OF KANSAS  
STATE CORPORATION COMMISSION

Give All Information Completely  
Make Required Affidavit  
Mail or Deliver Report to:  
Conservation Division  
State Corporation Commission  
212 North Market, Insurance Bldg.  
Wichita, Kansas

WELL PLUGGING RECORD

Graham County. Sec. 31 Twp. 9S Rge. (E) 23 (W)  
Location as "NE/CNW/SW" or footage from lines. CS $\frac{1}{2}$ -SE-NW  
Lease Owner Champlin Oil & Refining Co.  
Lease Name J. B. Cameron Well No. 1  
Office Address Box 308, Ellinwood, Kansas  
Character of Well (completed as Oil, Gas or Dry Hole) Dry hole  
Date well completed June 25, 19 61  
Application for plugging filed June 26, 19 61  
Application for plugging approved June 26, 19 61  
Plugging commenced June 25, 19 61  
Plugging completed June 25, 19 61  
Reason for abandonment of well or producing formation \_\_\_\_\_

NORTH

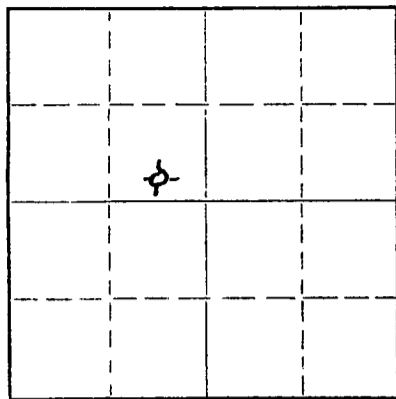

Locate well correctly on above  
Section Plat

If a producing well is abandoned, date of last production \_\_\_\_\_ 19 \_\_\_\_  
Was permission obtained from the Conservation Division or its agents before plugging was commenced? \_\_\_\_\_

Name of Conservation Agent who supervised plugging of this well Eldon Petty  
Producing formation \_\_\_\_\_ Depth to top \_\_\_\_\_ Bottom \_\_\_\_\_ Total Depth of Well 4055 Feet  
Show depth and thickness of all water, oil and gas formations.

OIL, GAS OR WATER RECORDS

CASING RECORD

FORMATION	CONTENT	FROM	TO	SIZE	PUT IN	PULLED OUT
				8-5/8" OD	223'	None

Describe in detail the manner in which the well was plugged, indicating where the mud fluid was placed and the method or methods used in introducing it into the hole. If cement or other plugs were used, state the character of same and depth placed, from \_\_\_\_\_ feet to \_\_\_\_\_ feet for each plug set.

Filled hole with heavy rotary mud from 4055' T.D. to 600' and set cement plug using 20 sacks of cement then filled hole with heavy mud to 180' and set cement plug using 20 sacks of cement then filled hole with heavy mud to 30' and set plug using 1/2 sack of hulls and 10 sacks of cement filling casing to bottom of cellar.

**RECEIVED**  
STATE CORPORATION COMMISSION  
JUN 28 1961  
CONSERVATION DIVISION  
Wichita, Kansas

(If additional description is necessary, use BACK of this sheet)

Name of Plugging Contractor Garvey Drilling Co.  
Address 352 N. Broadway, Wichita, Kansas

STATE OF KANSAS, COUNTY OF BARTON, ss.  
J. W. Meyers (employee of owner) or (owner or operator) of the above-described well, being first duly sworn on oath, says: That I have knowledge of the facts, statements, and matters herein contained and the log of the above-described well as filed and that the same are true and correct. So help me God.

(Signature) [Signature]  
Box 308, Ellinwood, Kansas  
(Address)

SUBSCRIBED AND SWORN TO before me this 27th day of June 19 61

[Signature]  
Notary Public.

My commission expires 5-22-62

