

STATE OF KANSAS
STATE CORPORATION COMMISSION

Form CP-4

Give All Information Completely
Make Required Affidavit
Mail or Deliver Report to:
Conservation Division
State Corporation Commission
212 No. Market
Wichita, Kansas 67202

WELL PLUGGING RECORD

Graham County, Sec. 31 Twp. 9 Rge. 23 (E) W (W)

Location as "NE/CNW/SE/SW" or footage from lines NE NE NW

Lease Owner Don E. Pratt Oil Operations

Lease Name Cameron Well No. 1

Office Address P. O. Drawer 370, Hays, Kansas 67601

Character of Well (completed as Oil, Gas or Dry Hole) Dry Hole

Date well completed 3-3-1971

Application for plugging filed 3-3-1971

Application for plugging approved 3-3-1971


Plugging commenced 3-3-1971

Plugging completed 3-3-1971

Reason for abandonment of well or producing formation Dry Hole

If a producing well is abandoned, date of last production 19

Was permission obtained from the Conservation Division or its agents before plugging was commenced? Yes

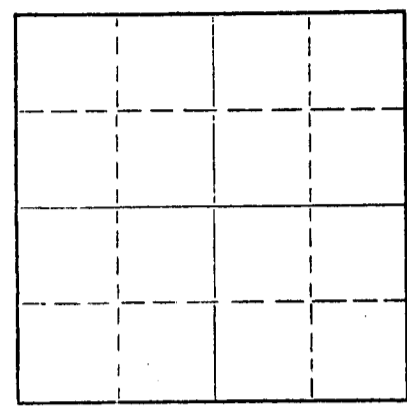

Locate well correctly on above
Section Plat

Name of Conservation Agent who supervised plugging of this well Bill Nichols

Producing formation _____ Depth to top _____ Bottom _____ Total Depth of Well _____ Feet

Show depth and thickness of all water, oil and gas formations.

OIL, GAS OR WATER RECORDS

CASING RECORD

FORMATION	CONTENT	FROM	TO	SIZE	PUT IN	PULLED OUT
Surface Pipe				8 5/8"	203'	

Describe in detail the manner in which the well was plugged, indicating where the mud fluid was placed and the method or methods used in introducing it into the hole. If cement or other plugs were used, state the character of same and depth placed, from _____ feet to _____ feet for each plug set.

1st plug was set at 1175' with 100 cu. ft. cement

2nd plug was set at 215' with 25 cu. ft. cement

3rd plug was set at 40' with 10 cu. ft. cement

RECEIVED
STATE CORPORATION COMMISSION
MAR 8 1971 3-8-71
CONSERVATION DIVISION
Wichita, Kansas

(If additional description is necessary, use BACK of this sheet)

Name of Plugging Contractor Dreiling Oil, Inc.


Address Victoria, Kansas 67671

STATE OF KANSAS, COUNTY OF ELLIS, ss.

I, Leo F. Dreiling, Pres. of Drilg. Cont. of the above-described well, being first duly sworn on oath, says: That I have knowledge of the facts, statements, and matters herein contained and the log of the above described well as filed and that the same are true and correct. So help me God.

(Signature) Leo F. Dreiling

LEO F. DREILING, ROUTE 2, VICTORIA, KANSAS 67671
(Address)

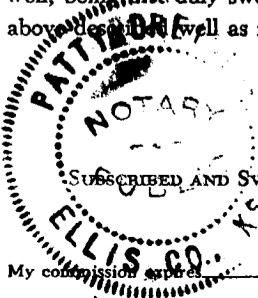

SUBSCRIBED AND SWORN TO before me this 5th day of March, 19 71

My commission expires

January 13, 1975

Patty Dreiling
PATTY DREILING

Notary Public.

15-065-204-0200

DREILING OIL, INC.

Victoria, Kansas 67671

WELL LOG

Company	Don E. Pratt Oil Operations P. O. Drawer 370 Hays, Kansas 67601	Sec. 31	Twp	Rng. 23
Farm	Cameron No 1	Location	NE NE NE	
Total Depth	3838'	County	Graham	
Conun.	2-27-71 Comp. 3-3-71	Elevation.	2480'	R. B.
Contractor	Dreiling Oil, Inc. Victoria, Kansas 67671		2477'	D. F.
			2475'	G. R.

Casing Record	Cement Record	Production
203' - 8 5/8"	160 sacks cement	D & A

Figures Indicate Bottom of Formations

0'	100'	Top Soil & Sand
100'	130'	Gravel
130'	150'	Blue Shale
150'	203'	Blue Shale
203'	1180'	Shale
1180'	1640'	Shale
1640'	1848'	Sand
1848'	2050'	Red Bed & Shale
2050'	2099'	Shale & Red Bed
2099'	2136'	Anhydrite
2136'	2575'	Shale
2575'	2840'	Shale
2840'	2975'	Shale & Lime
2975'	3225'	Shale & Lime
3225'	3325'	Shale & Lime
3325'	3555'	Shale & Lime
3555'	3738'	Lime & Shale
3738'	3838'	Lime
3838'	T.D.	

STATE OF KANSAS)
)ss
COUNTY OF ELLIS)

I, Leo F. Dreiling, of Dreiling Oil, Inc., upon oath states that
above and foregoing is a true and correct copy from the Daily Drilling Report
from your Cameron #1.

LEO F. DREILING

Subscribed and sworn to before me this 5th day of March, 1971.

PATTY DREILING NOTARY PUBLIC

My commission expires: January 13, 1975

